


# T. 39S. R 35E. W.M.

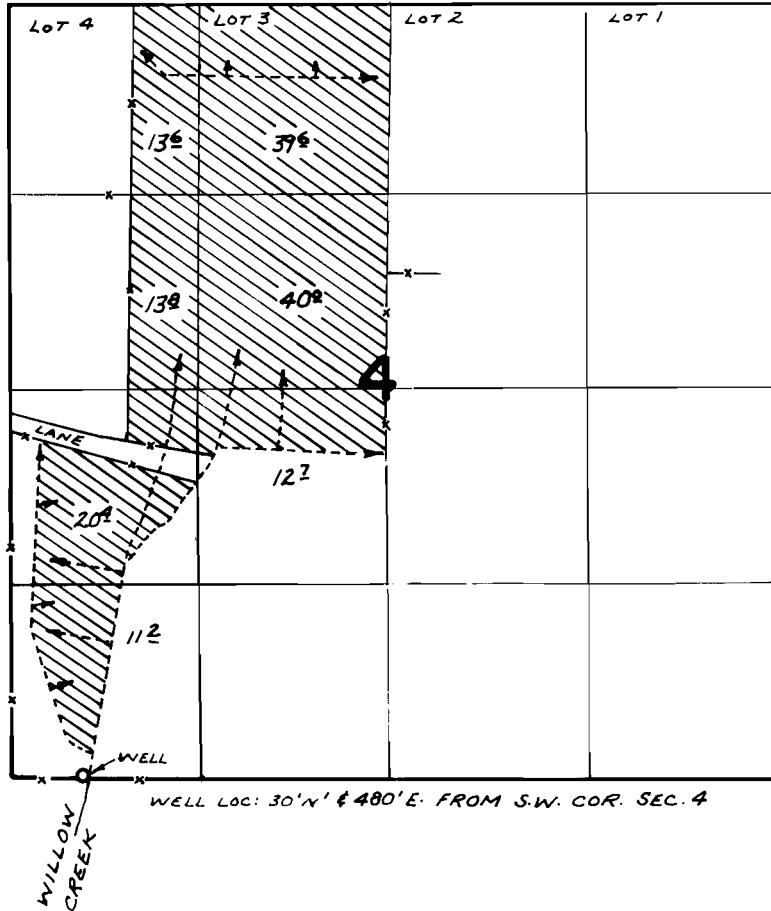

## FINAL PROOF SURVEY UNDER

Application No. *G-4160* Permit No. *G-3912*  
IN NAME OF

*RONALD McLEAN*

Surveyed *JUNE 19, 1976.* by *R. MUCKEN*