


T.36S.,R.3W.,W.M.

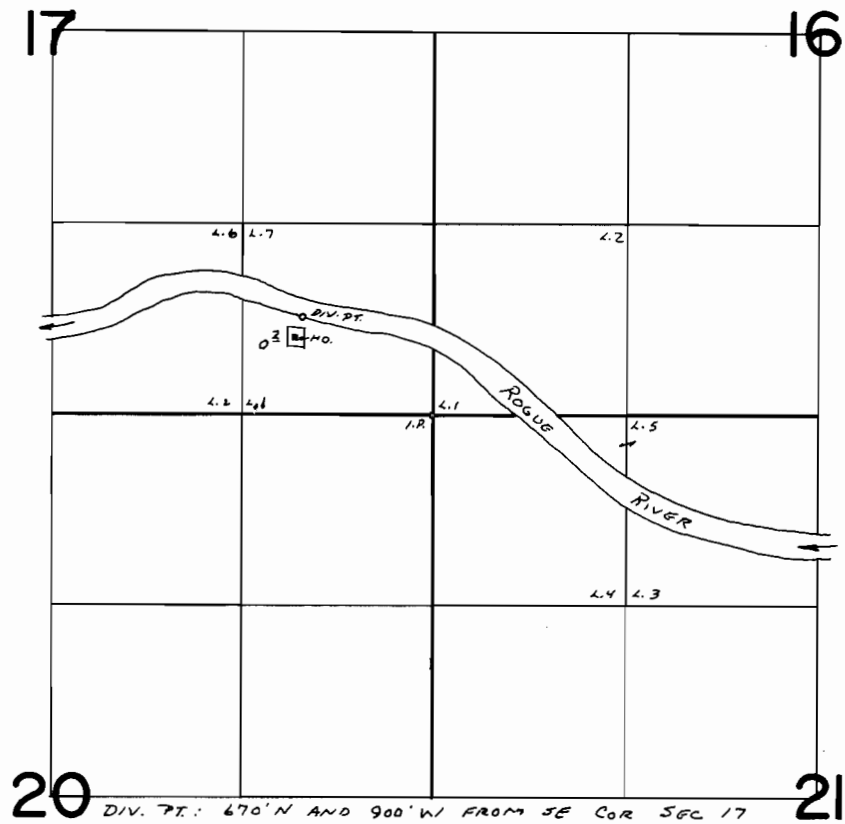

FINAL PROOF SURVEY
UNDER

Application No. 42334 Permit No. 31649
IN NAME OF

M. S. & VALERIE NADLER

Surveyed Aug. 14 1975, by L. E. Gentry