


# T.38S. R.3W. W.M.

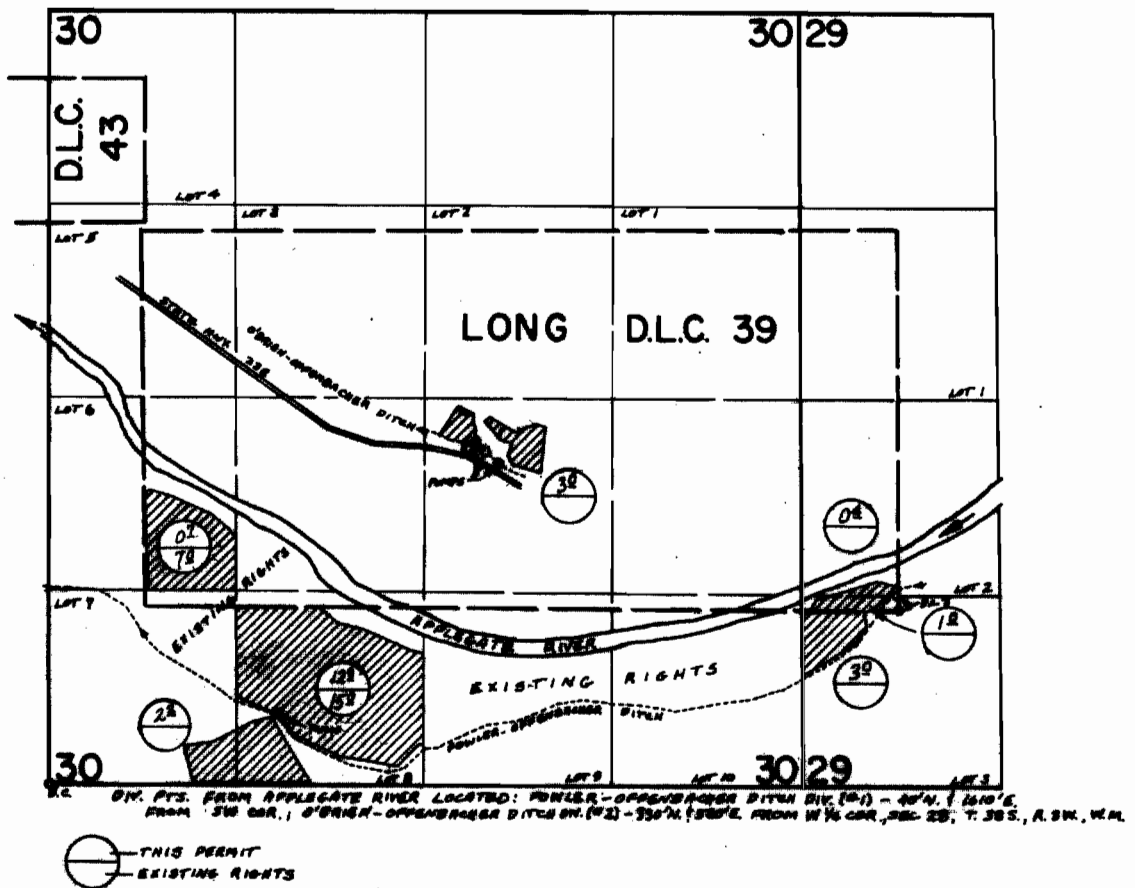

## FINAL PROOF SURVEY UNDER

Application No. 42715 Permit No. 31914  
 IN NAME OF

THE ESTATES OF LEON & LANCE OFFENBACHER

Surveyed AUG. 12-13, 1975, by L. TOLL