


T.40S.,R.8W.,W.M.

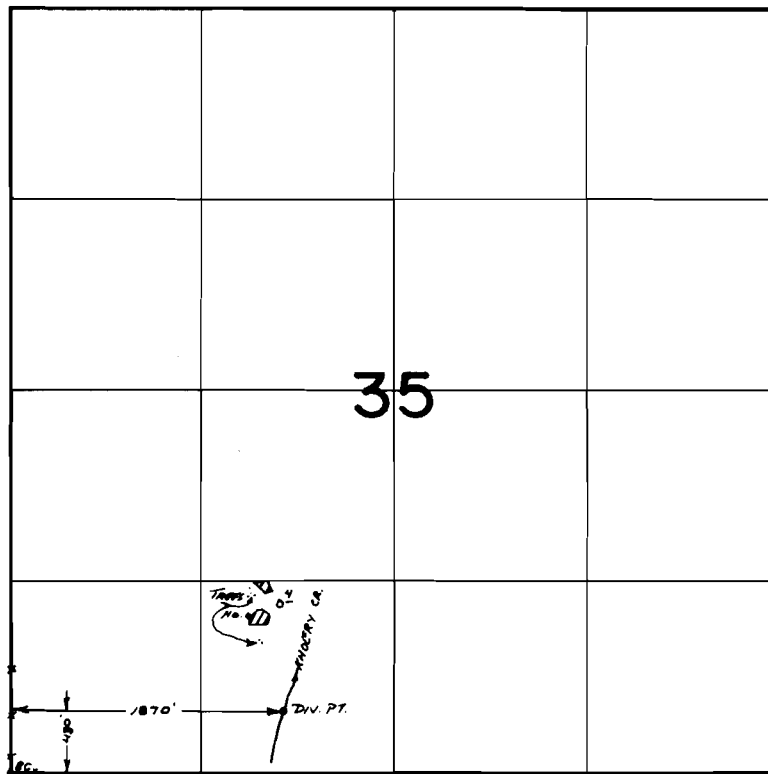

FINAL PROOF SURVEY
UNDER

Application No. 46292 Permit No. 34578
IN NAME OF

LANCE BISACCIA & NATASHA MORRIS

Surveyed Mar. 2 1975, by L. Tall