


33602

44835

T.39S. R.19E. W.M.

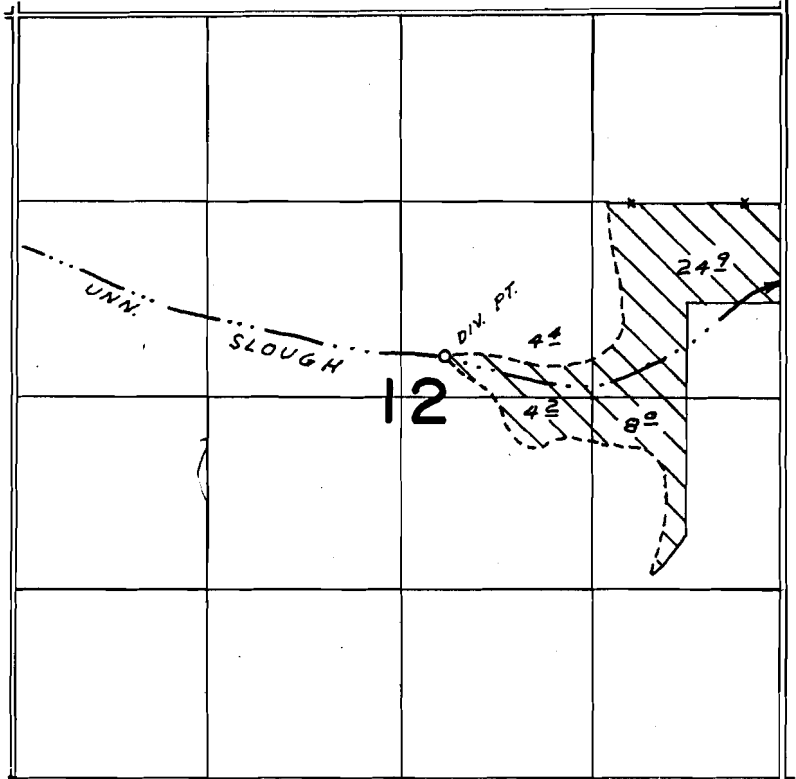

DIV. PT. LOC. 270' N. & 2320' W FROM E. 1/4 COR. SEC. 12

FINAL PROOF SURVEY UNDER

Application No. 45040... Permit No. 33662...
IN NAME OF
ESTHER M. DUNGAN
.....ESTATE OF T.W. DUNGAN.....

Surveyed JUL...10... 1975., by L.H. NUNN.....