


T.17S. R.6W. W.M.

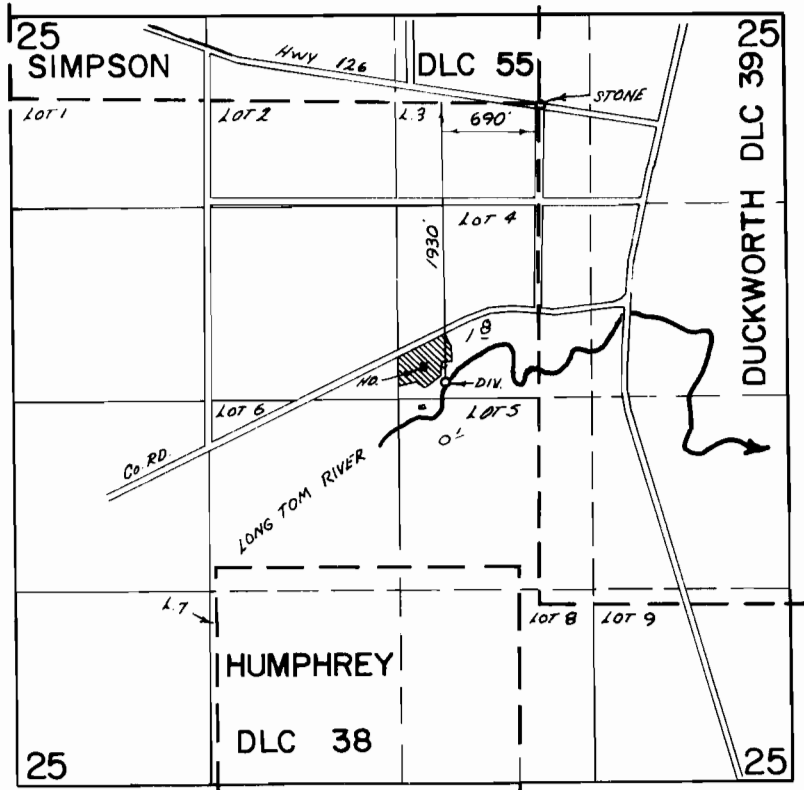

FINAL PROOF SURVEY
UNDER

Application No. 41966... Permit No. 31359 ...
IN NAME OF

AUGUST W. & HILDA E. WEIGHT

Surveyed May 7... 1974, by T. J. PAUL ...