


T.11S., R.8W., W.M.

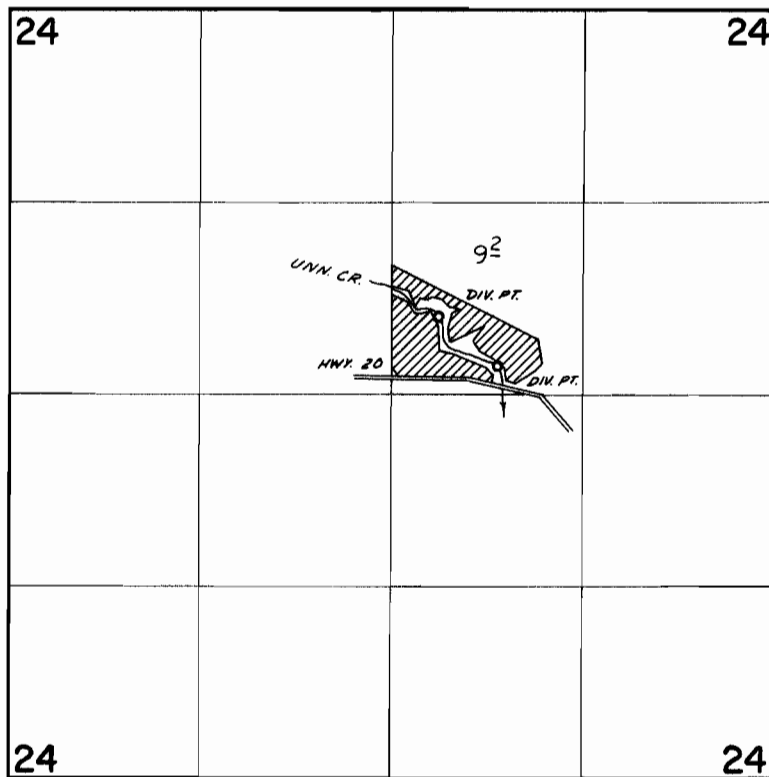

DIV. PTS. LOC.: W'LY- 530' N & 320' E; E'LY- 190' N & 720' E BOTH
FROM CENTER SEC. 24

FINAL PROOF SURVEY
UNDER

Application No. 33872 Permit No. 26807
IN NAME OF

LAWRENCE B. COOK

Surveyed June 6 1975, by D. Norby