


T.10&11S., R.8W., W.M.

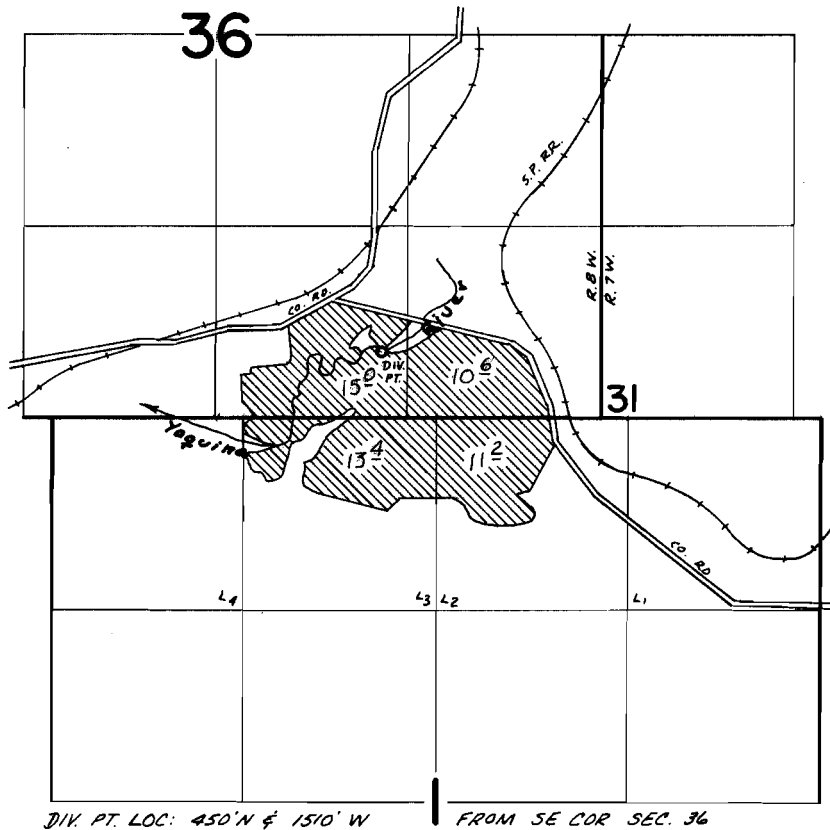

FINAL PROOF SURVEY
UNDER

Application No. 44416 Permit No. 33178
IN NAME OF

J. D. HUMPHREY

Surveyed June 6 1975, by D. Norby