


T.10S., R.10W., W.M.

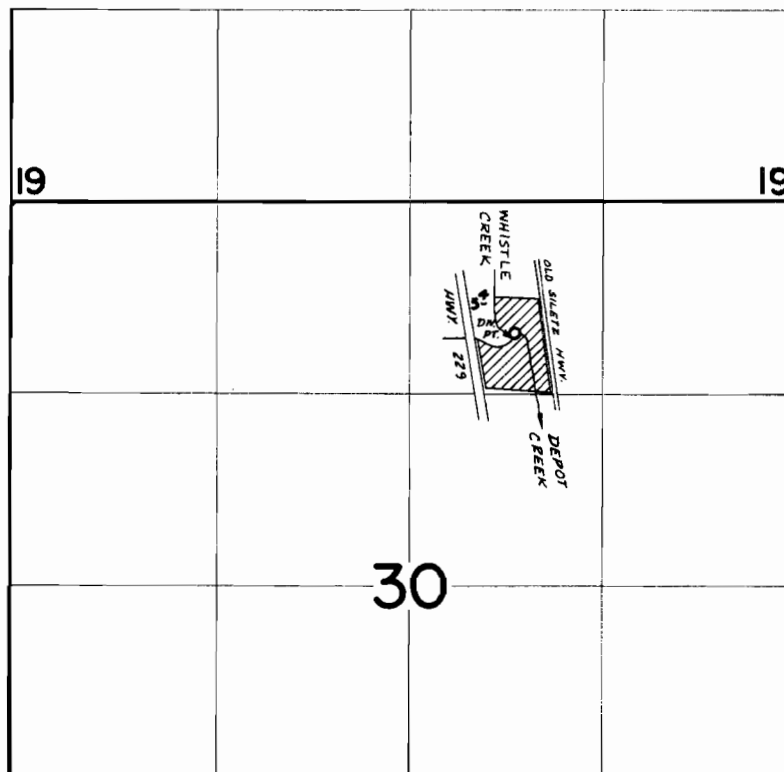

DIV. PT. LOC: 420' N & 720' E FROM SW COR. NW $\frac{1}{4}$ NE $\frac{1}{4}$ SEC. 30

FINAL PROOF SURVEY
UNDER

Application No. 47359 Permit No. 35474
IN NAME OF

VERNON M. KANNEY

Surveyed June 4 1975, by D. Norby