


T.IOS., R.IOW., W.M.

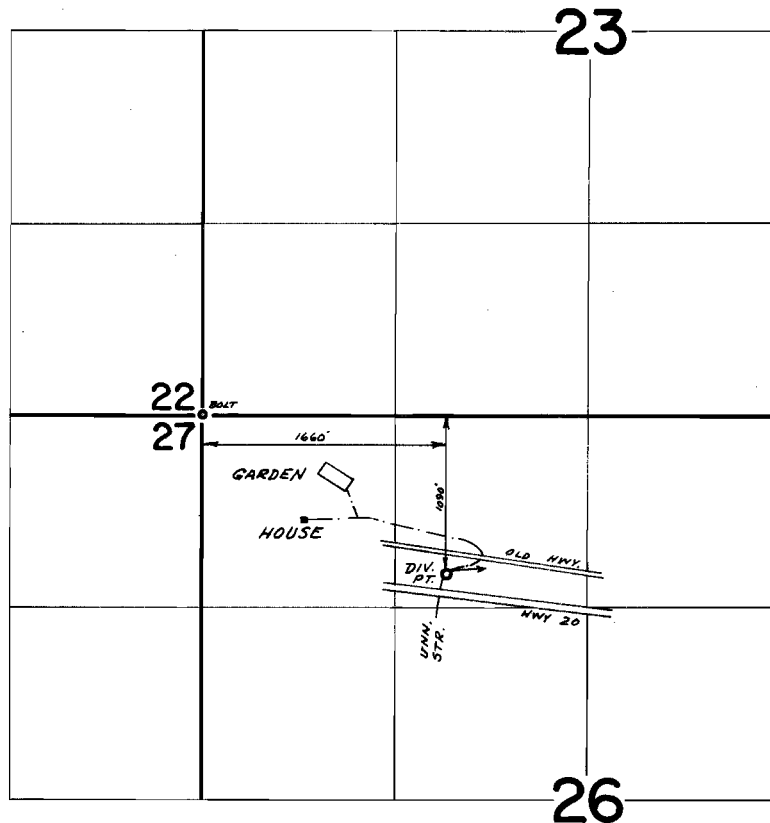

FINAL PROOF SURVEY
UNDER

Application No. 48238 Permit No. 35916
IN NAME OF

ERNEST H. AND MABEL J. COOK

Surveyed June 5 1975, by D. Norby