


T.29&30S., R.45E., W.M.

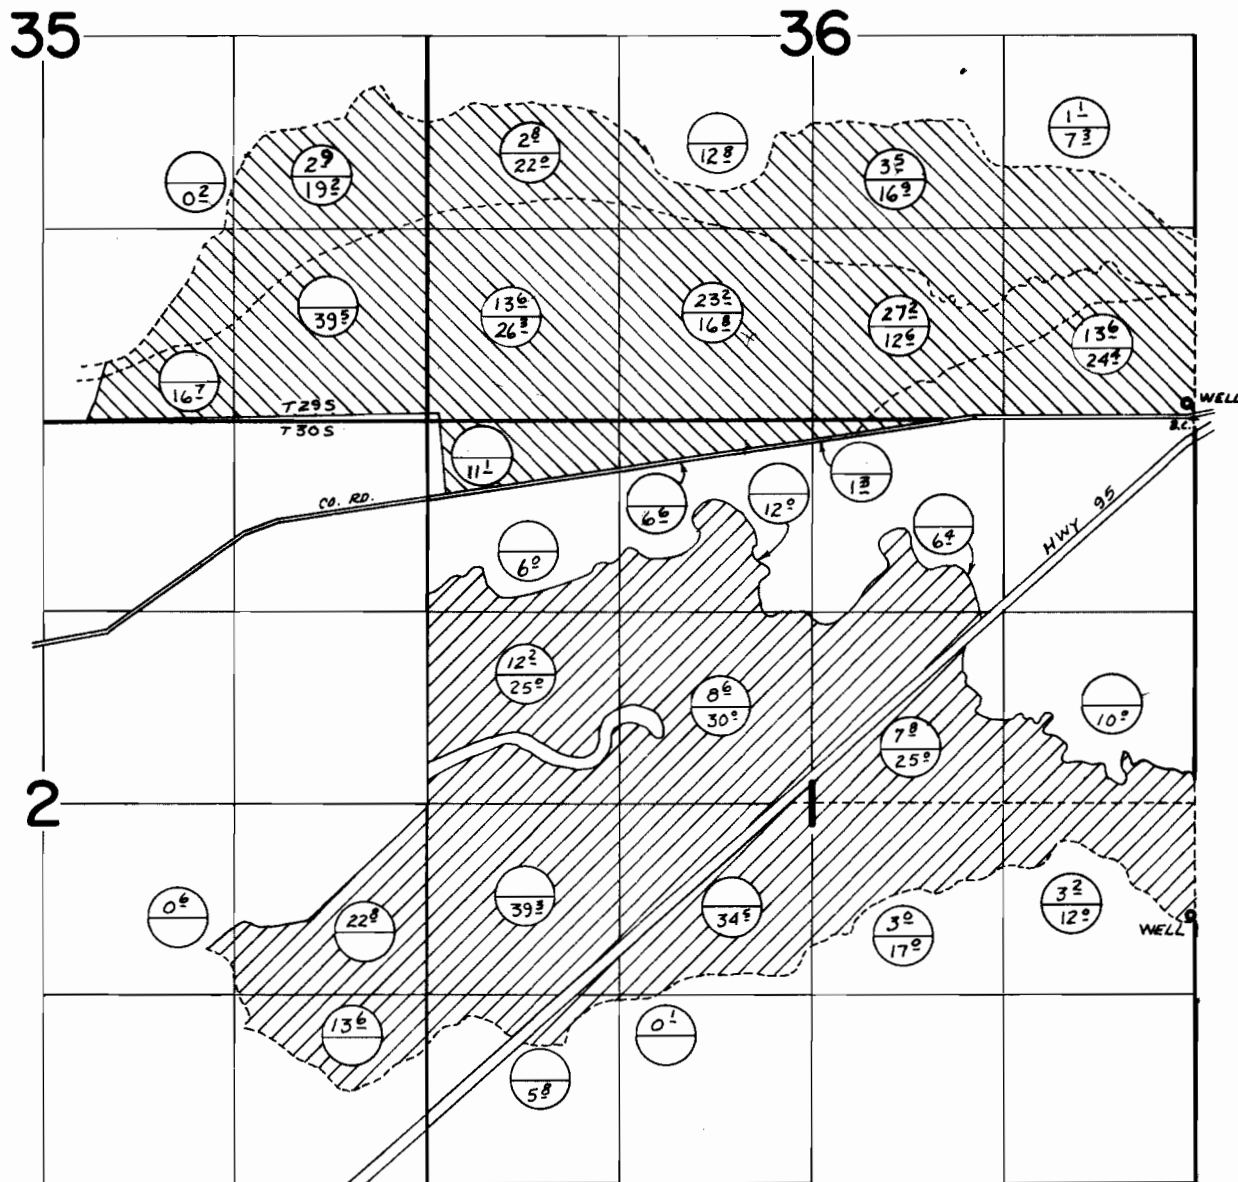

WELLS LOC: NLY - 100' N & 40' W FROM SE COR. SEC. 36; SLY - 1840' N & 20' W FROM SE COR. SEC. 1.

FINAL PROOF SURVEY UNDER

FROM NORTH WELL
UNDER APP. G-3616
FROM SOUTH WELL
UNDER APP. G-2982

Application No. G-2982 G-3616 Permit No. G-2786 G-3399
IN NAME OF

ESTATE OF JEFF ANDERSON

Surveyed July 15, 1975, by D. Norby

PRIMARY
SUPPLEMENTAL