


T.16 S. R.43 E. W.M.

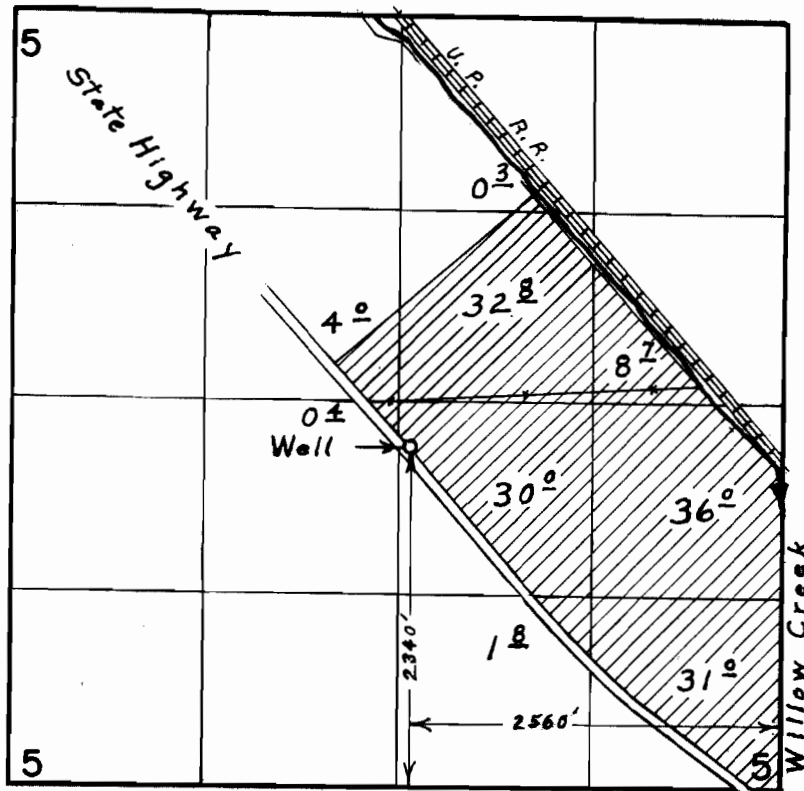

**FINAL PROOF SURVEY**  
UNDER

Application No. G-3383 Permit No. G-3180  
IN NAME OF

ELDORADO RANCH INC.

Surveyed May 1, 1975, by L. E. Gould