


T.28S., R.46E., W.M.

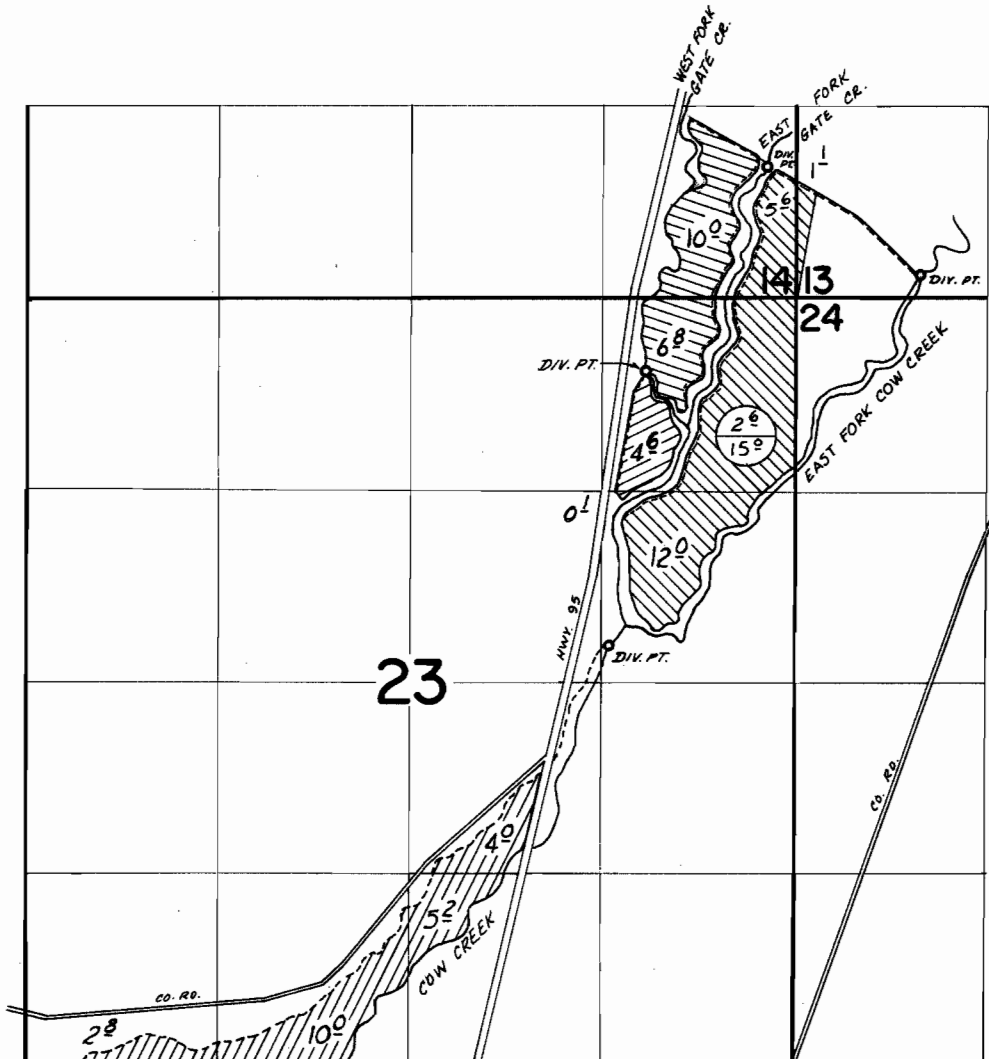


DIV. PTS. LOC: W. FK. GATE CR. - 500'S & 1030'W; E. FK. GATE CR. - 900'N & 200'W;
E. FK. COW CR. - 150'N & 850'E; COW CR. - 2390'S & 1270'W ALL FROM
NE COR. SEC. 23.

FINAL PROOF SURVEY UNDER

Application No. 41691 Permit No. 31102
41692 31103
IN NAME OF

BALTZOR CATTLE CO., INC.

Surveyed July 17 1975, by D. Norby

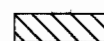-  EAST FORK COW CREEK
A-41692
-  EAST FORK GATE CREEK
A-41692
-  WEST FORK GATE CREEK
A-41692
-  COW CREEK
A-41691

 APPLICATION 41692
CERT. - 8377