


T.28S., R.46E., W.M.

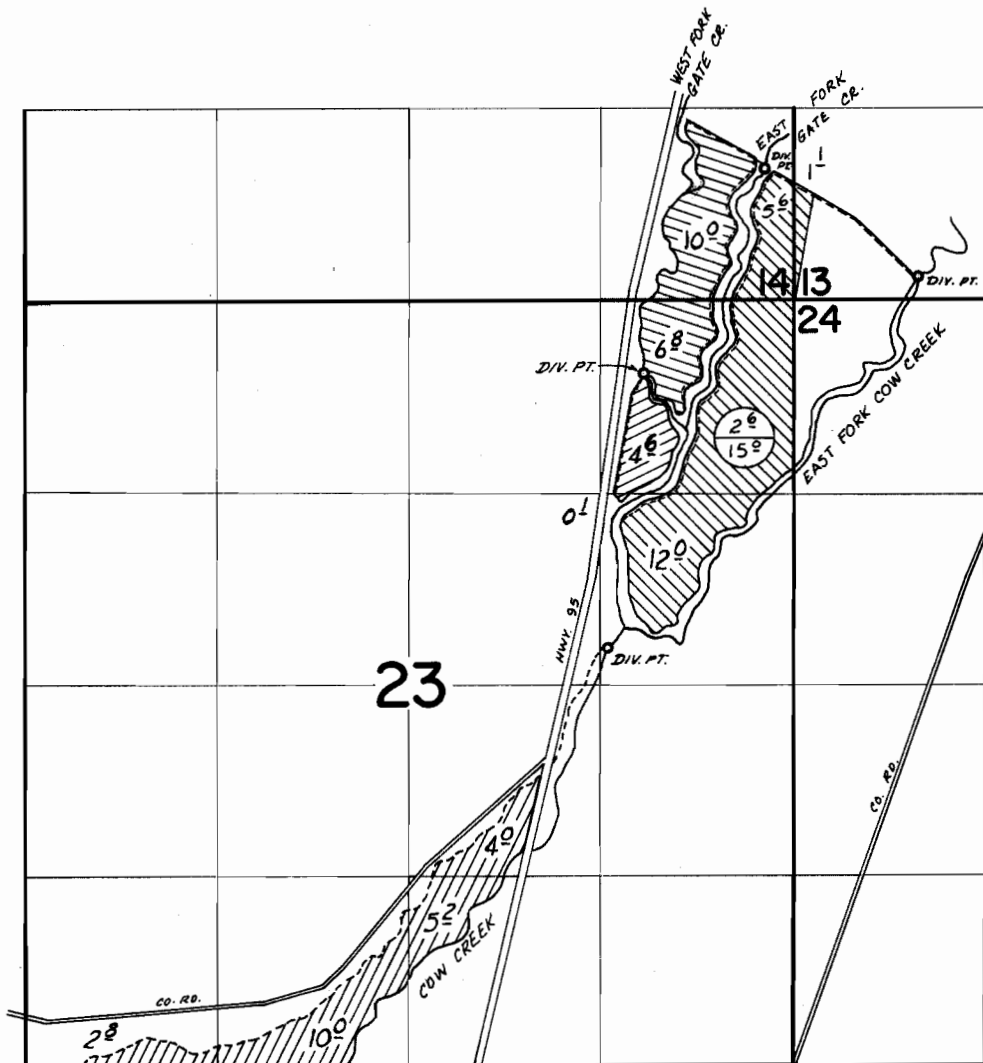

DIV. PTS. LOC: W. FK. GATE CR. - 500'S & 1030'W; E. FK. GATE CR. - 900'N & 200'W;
E. FK. COW CR. - 150'N & 880'E; COW CR. - 2390'S & 1270'W ALL FROM
NE COR. SEC. 23.

FINAL PROOF SURVEY **UNDER**

Application No. **41691** Permit No. **31102**
41692 **31103**
IN NAME OF

BALTZOR CATTLE CO., INC.

Surveyed July 17 1975, by D. Norby

-  EAST FORK COW CREEK
A-41692
-  EAST FORK GATE CREEK
A-41692
-  WEST FORK GATE CREEK
A-41692
-  COW CREEK
A-41691

 APPLICATION 41692
CERT. - 8377