


T. 39S., R. 41E., W.M.

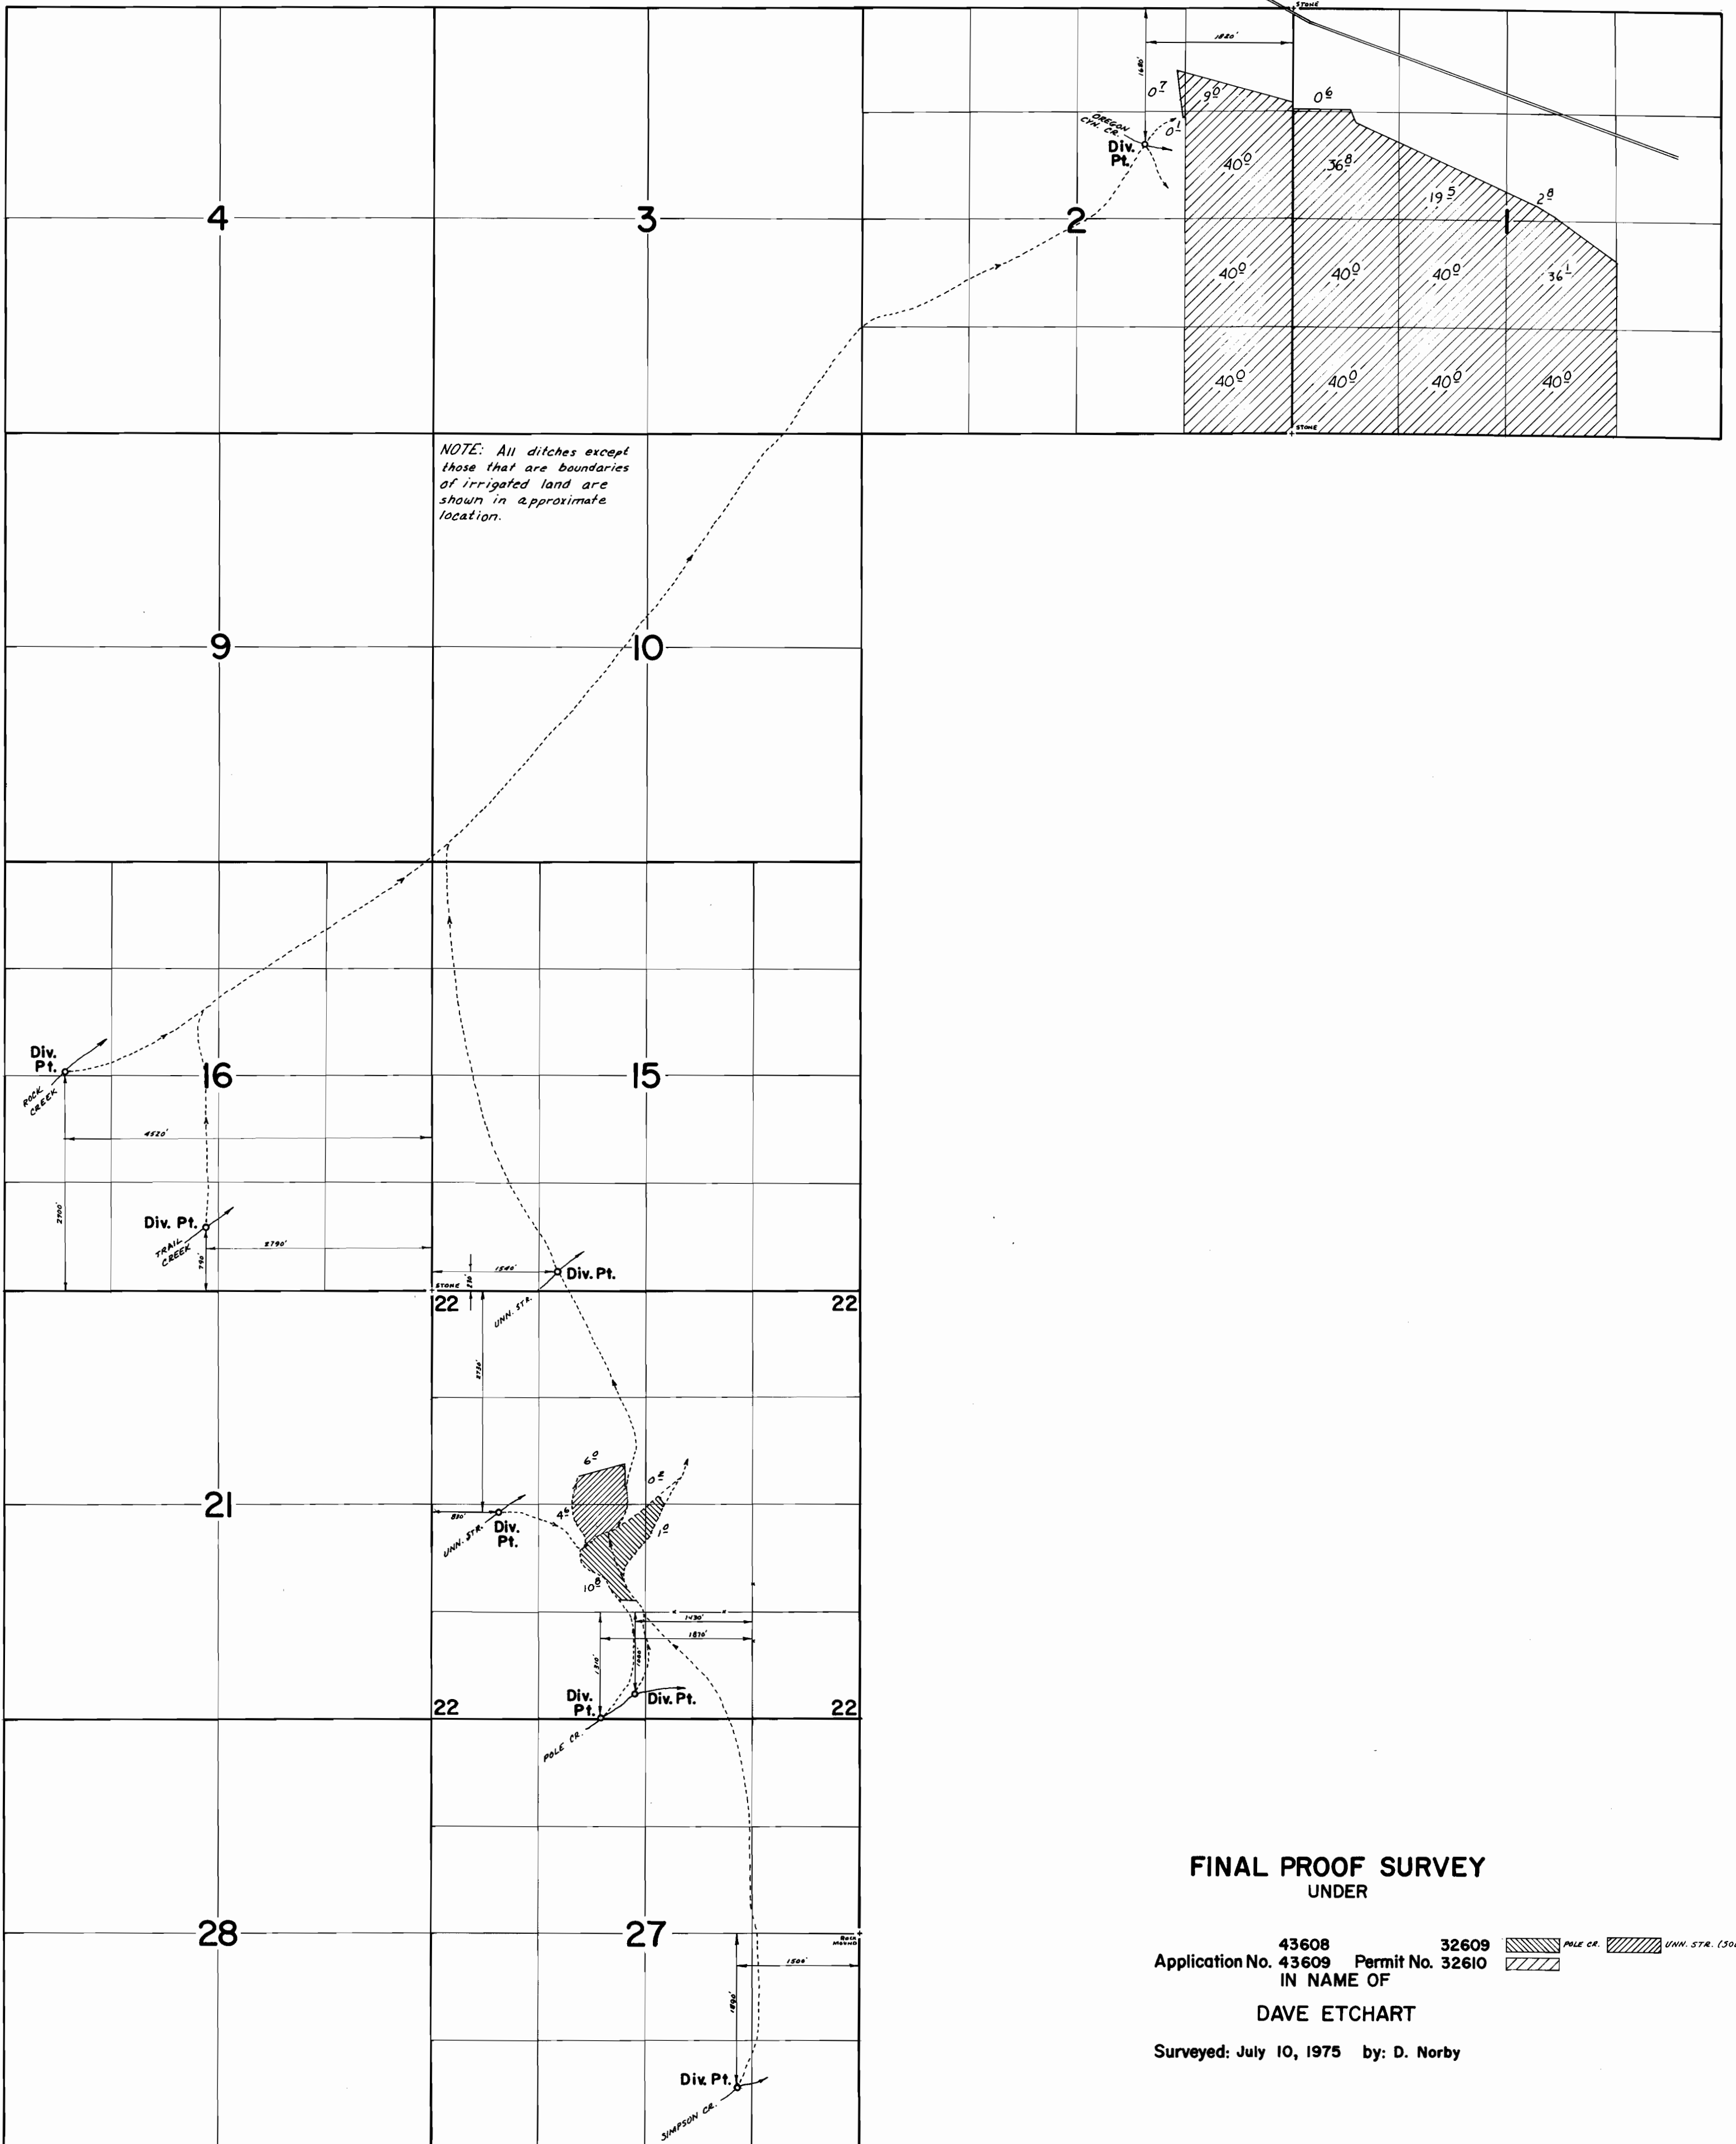

FINAL PROOF SURVEY
UNDER

Application No. 43608 32609 32610
 Permit No. 32610
 IN NAME OF

DAVE ETCHART

Surveyed: July 10, 1975 by: D. Norby