


T.30S., R.44&45E., W.M.

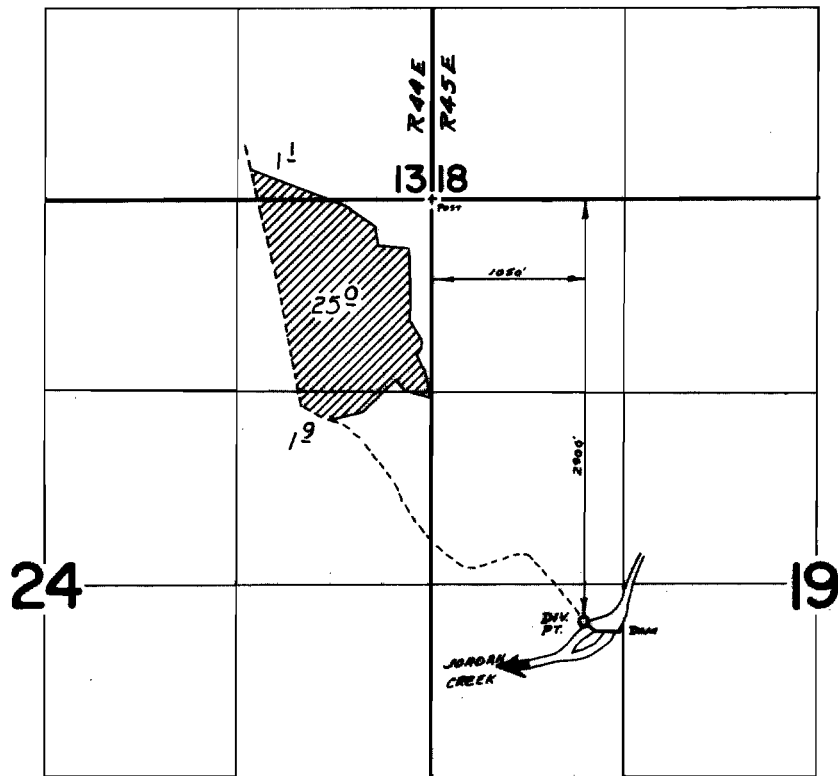

FINAL PROOF SURVEY
UNDER

Application No. 45793 Permit No. 34176
IN NAME OF

S. K. SKINNER AND SONS

Surveyed July 16 1975, by D. Norby