


# T.6S., R.3W., W.M.

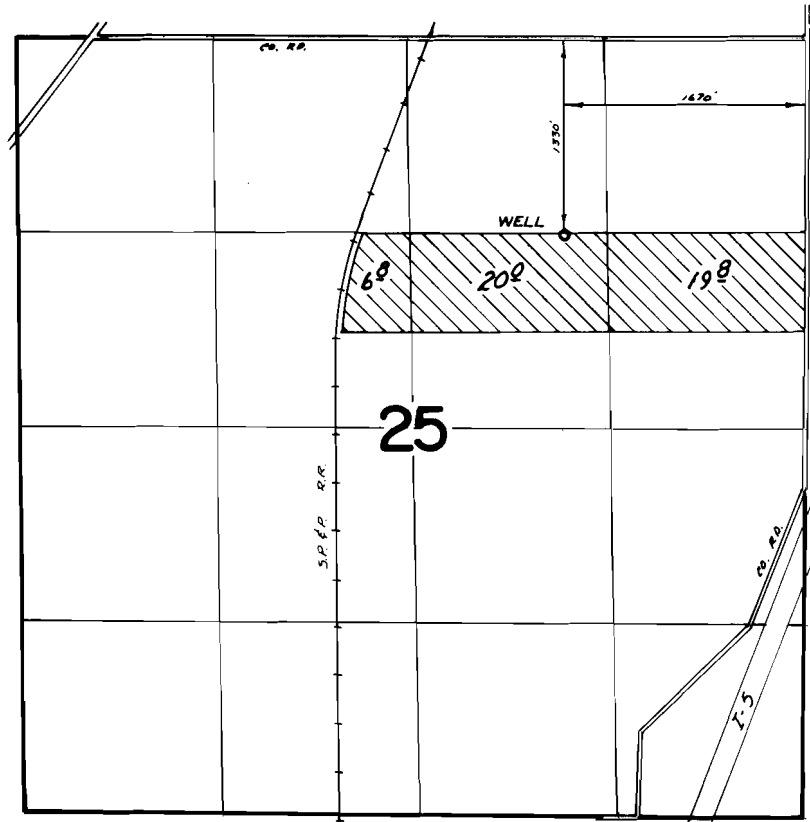

## FINAL PROOF SURVEY UNDER

Application No. G-4311 Permit No. G-4071  
IN NAME OF

ALICE M. DOERFLER

Surveyed Mar. 27 1975, by D. Norby