


T.6S., R.1W., W.M.

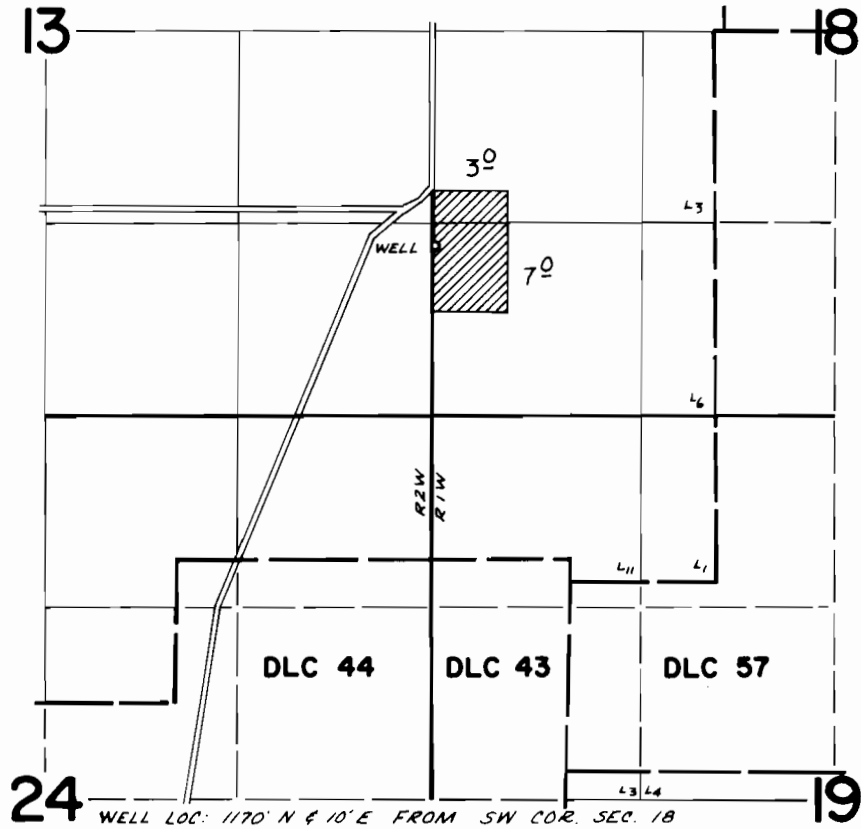

FINAL PROOF SURVEY UNDER

Application No. G-4927 Permit No. G-4651
IN NAME OF

ARLIN A. STAAB

Surveyed Mar. 28 1975, by D. Norby