


T.5S., R.2W., W.M.

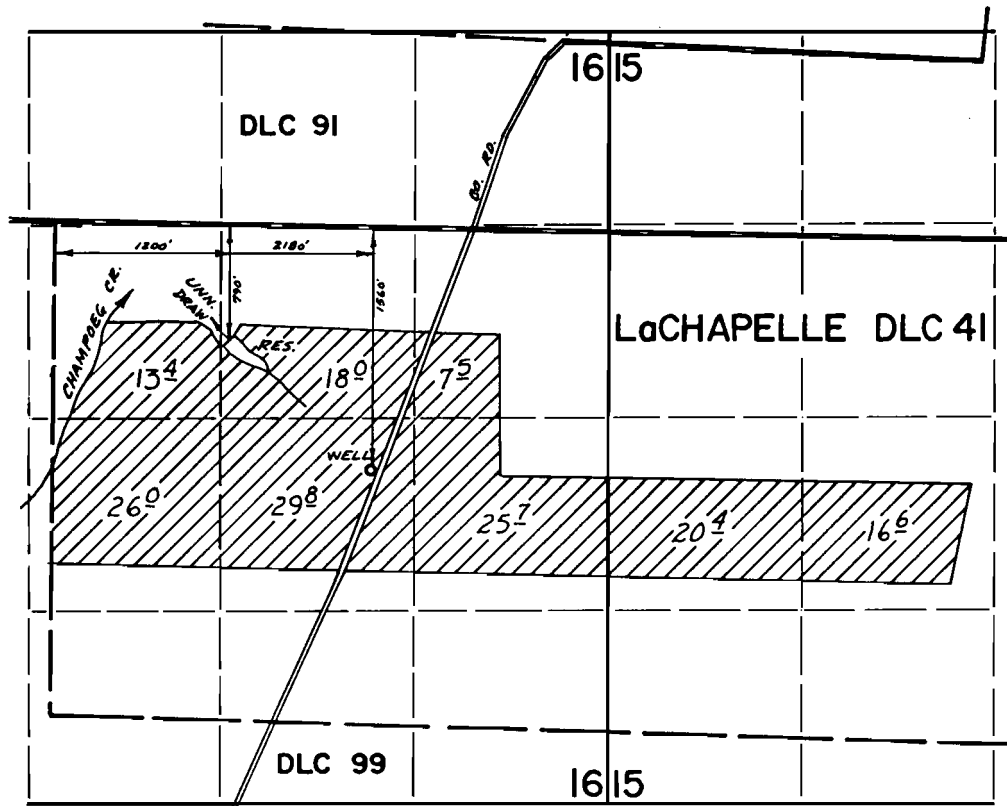

**FINAL PROOF SURVEY**  
UNDER

G-5612                      G-4975  
R-48648                    R-5785  
Application No. 48649    Permit No. 35823  
IN NAME OF

RICHARD Z. HAWES

Surveyed Aug. 11 1975, by D. Norby