


T.6S., R.2W., W.M.

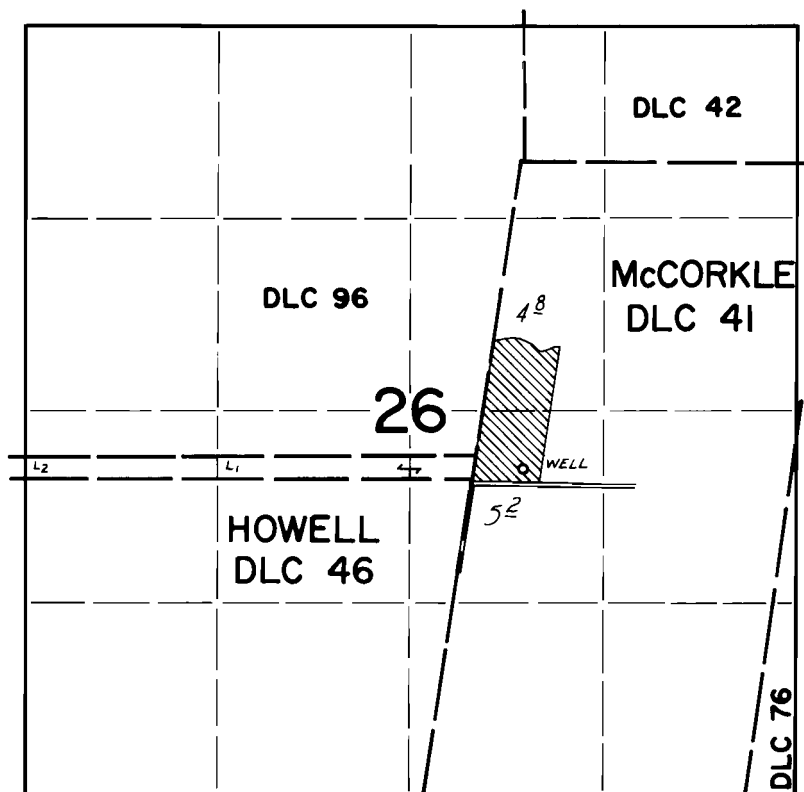

WELL LOC: 100' N & 350' E FROM NE COR. HOWELL DLC 46

FINAL PROOF SURVEY
UNDER

Application No. G-5621 Permit No. G-5010
IN NAME OF

MARSHALL T. RAY

Surveyed July 31 1975, by D. Norby