


T.6S., R.2W., W.M.

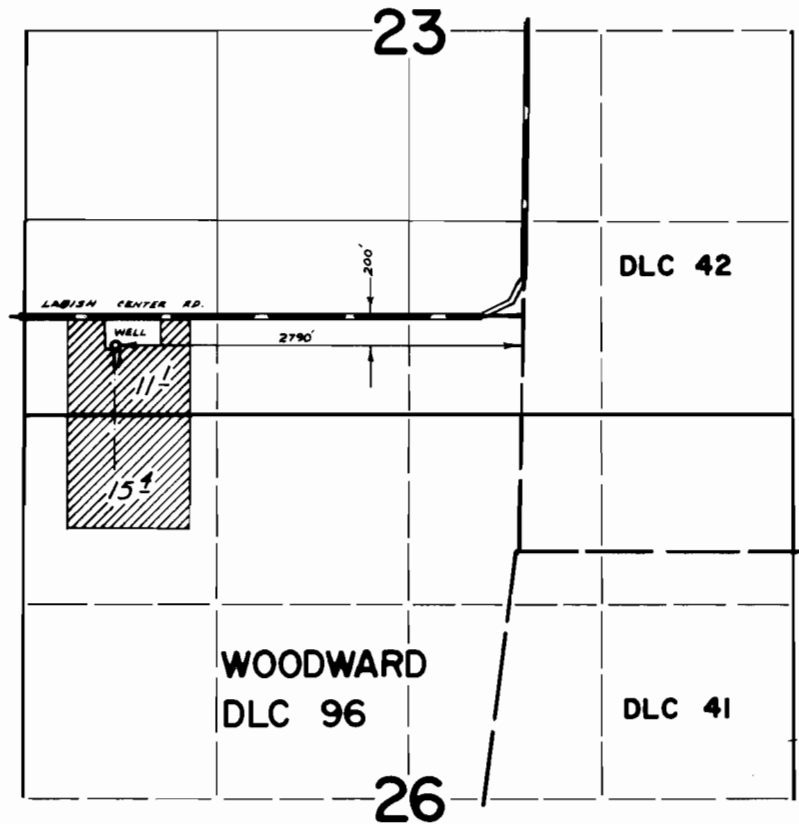

FINAL PROOF SURVEY
UNDER

Application No. G-6276 Permit No. G-5200
IN NAME OF

DONALD D. GREGG

Surveyed Aug. 11 1975, by D. Norby