


T.8S., R.4W., W.M.

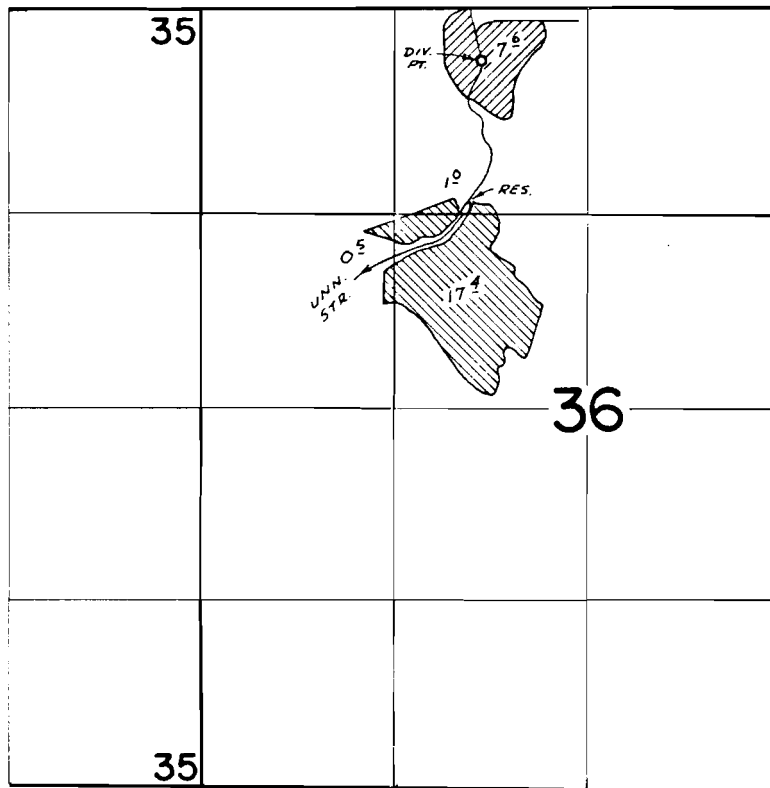

DIV. PT. LOC: STR. - 350' S & 1910' E; RES: 1400' S & 1800' E BOTH FROM NW COR. SEC. 36

FINAL PROOF SURVEY
UNDER

 STR. ONLY
 RES. & STR.

Application No. R-42063 42064 Permit No. R-4784 31484
IN NAME OF

GEORGE L. STENDER

Surveyed May 27 1975, by D. Norby