


T.5S., R.2&3W., W.M.

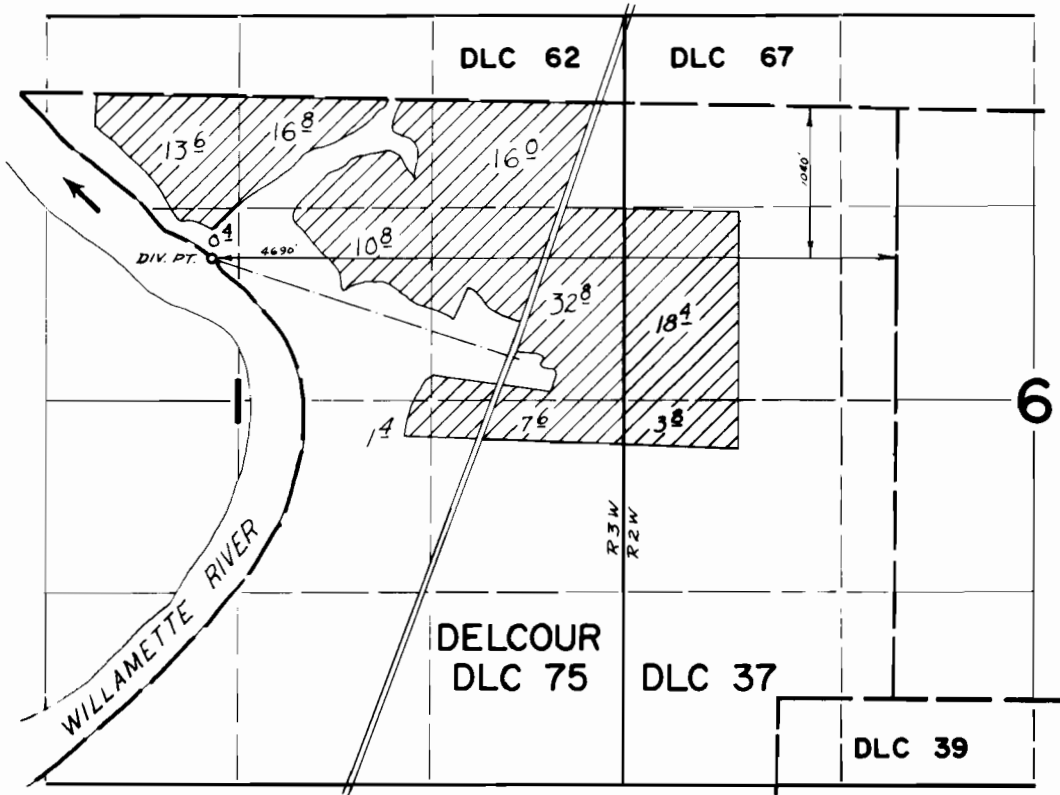

**FINAL PROOF SURVEY**  
UNDER

Application No. 46124 Permit No. 34460  
IN NAME OF

MARION WILSON

Surveyed April 11 1975, by D. Norby