


T.5S., R.2W., W.M.

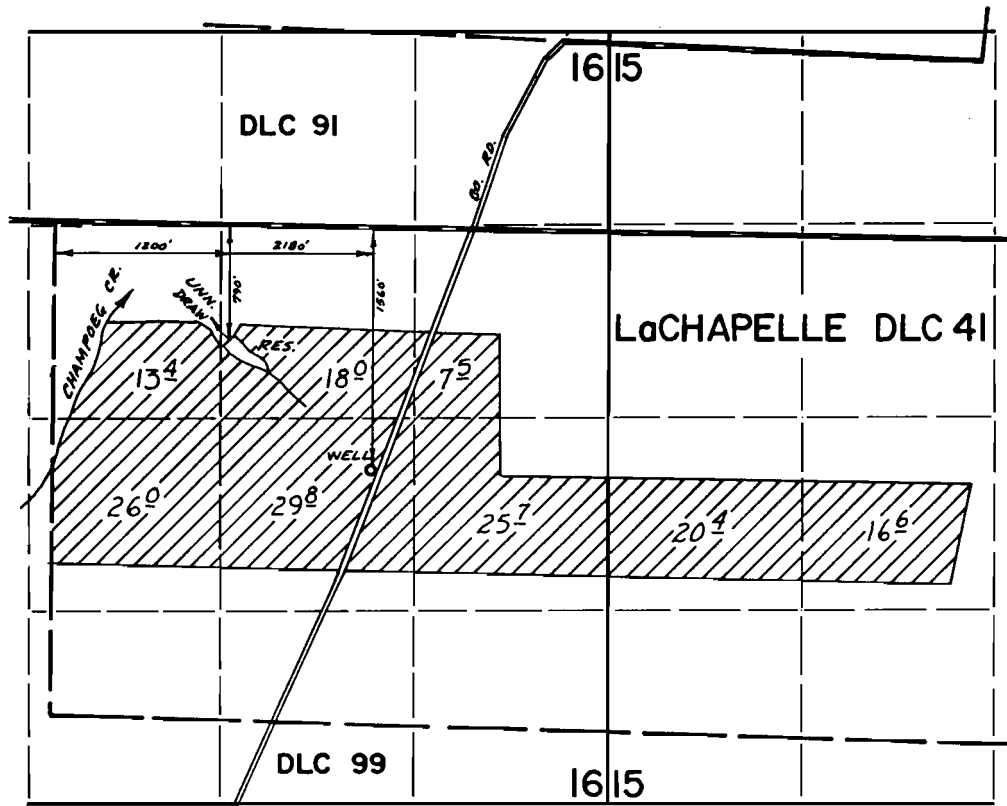

FINAL PROOF SURVEY
UNDER

G-5612 G-4975
R-48648 R-5785
Application No. 48649 Permit No. 35823
IN NAME OF

RICHARD Z. HAWES

Surveyed Aug. 11 1975, by D. Norby