


T.6S., R.IW., W.M.

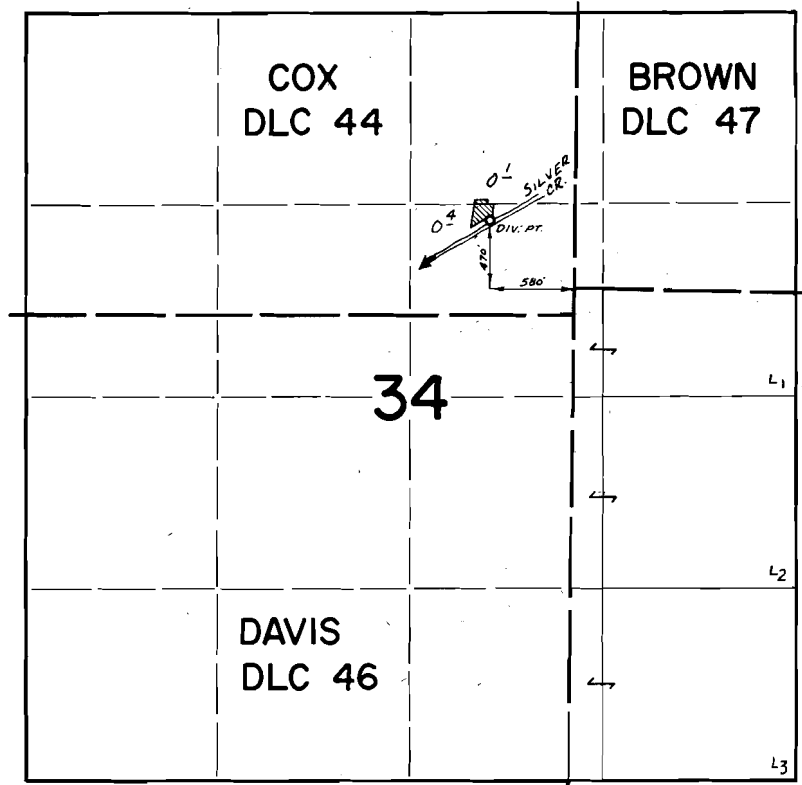

FINAL PROOF SURVEY UNDER

Application No. 50076 Permit No. 37632
IN NAME OF

HAROLD F. NEUWIRTH

Surveyed Aug. 12 1975, by D. Norby