


T.5S., R.1W., W.M.

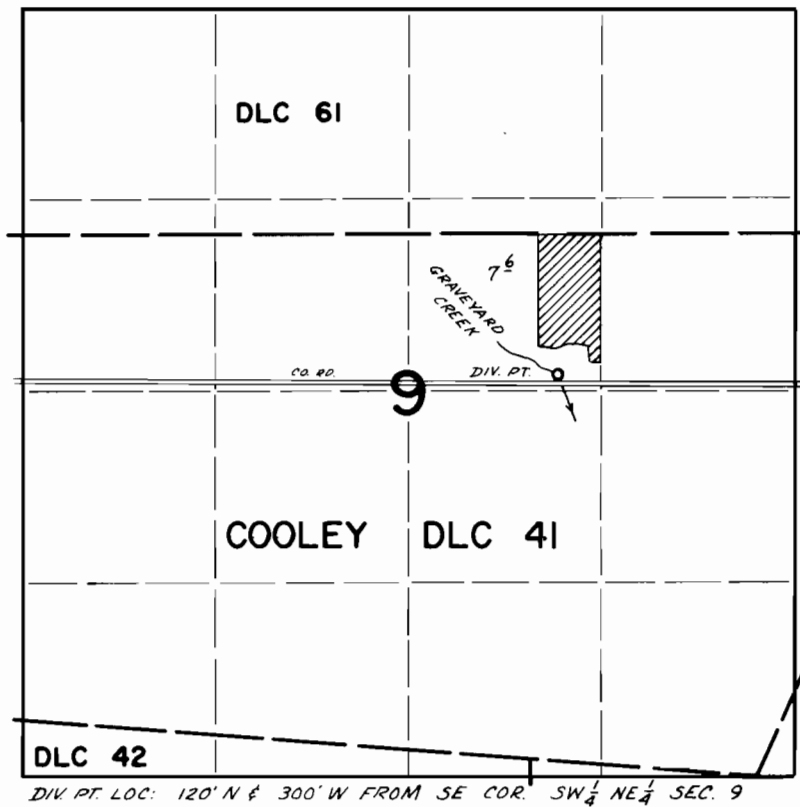

**FINAL PROOF SURVEY**  
UNDER

Application No. 52364 Permit No. 37449  
IN NAME OF  
IGNATEI SNEGIREV

Surveyed July 31 1975, by D. Norby