


64289
44880

T.384S. R.25E. W.M.

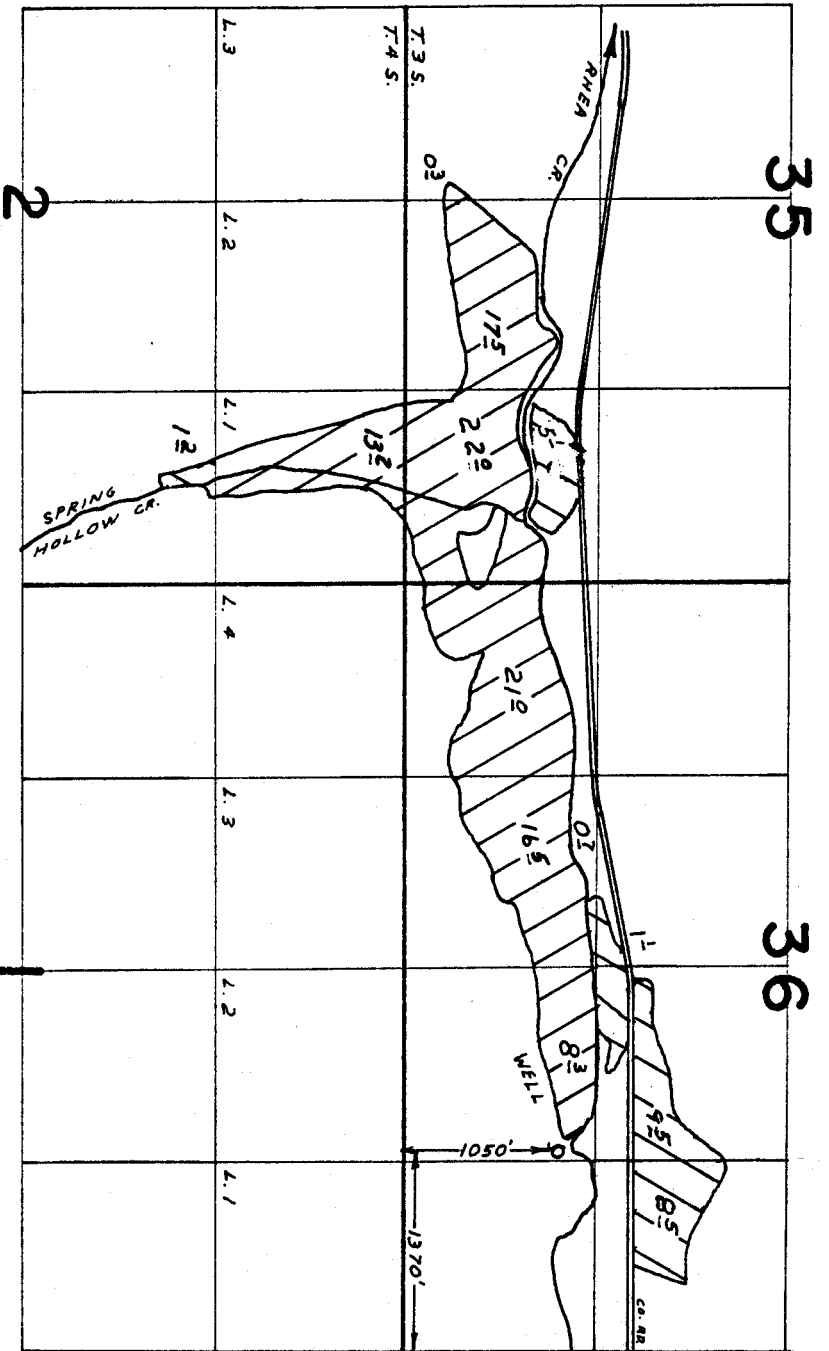

FINAL PROOF SURVEY

UNDER

Application No. G-4565 Permit No. G-4289

IN NAME OF

ORIAN E. WRIGHT

Surveyed SEP. 11, 1975, by L.H. NUNN