


T. 1 S. R. 27 E. W. M.

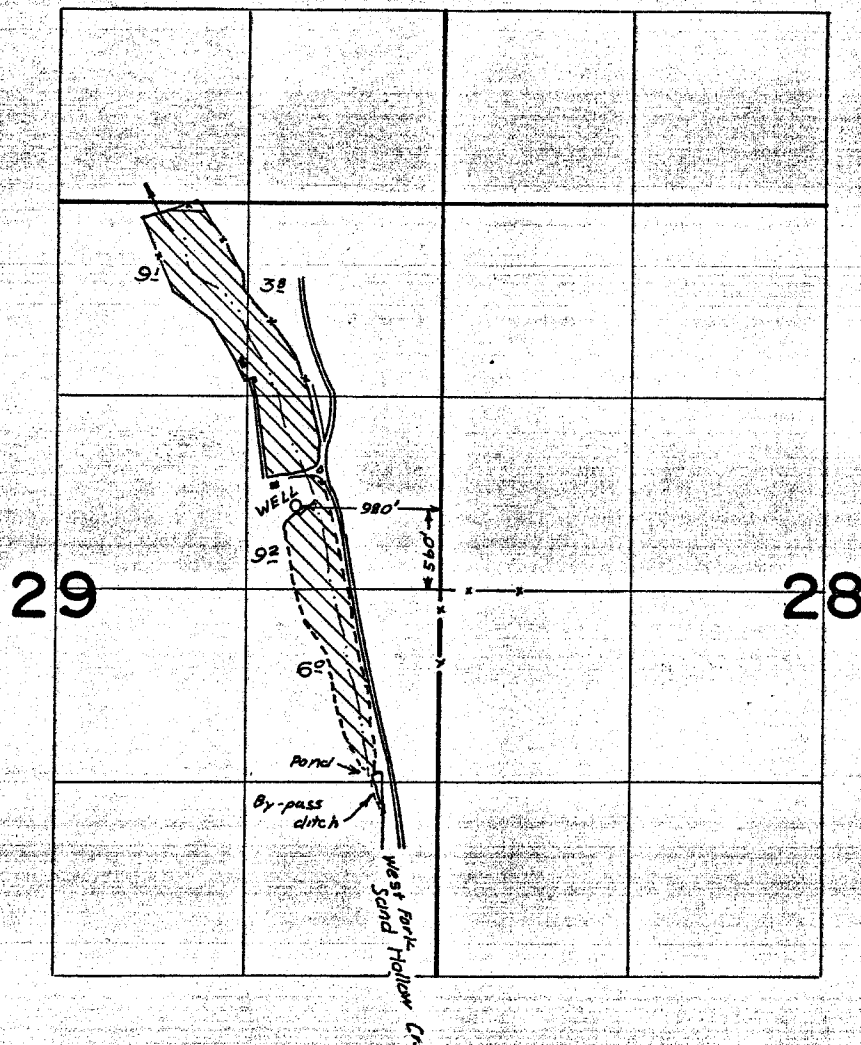

**FINAL PROOF SURVEY
UNDER**

Application No. G-5210... Permit No. G-5074..
IN NAME OF

R.B. FERGUSON

Surveyed SEP 12 1975, by L.H. NUNN