


T.6S. R.3W. W.M.

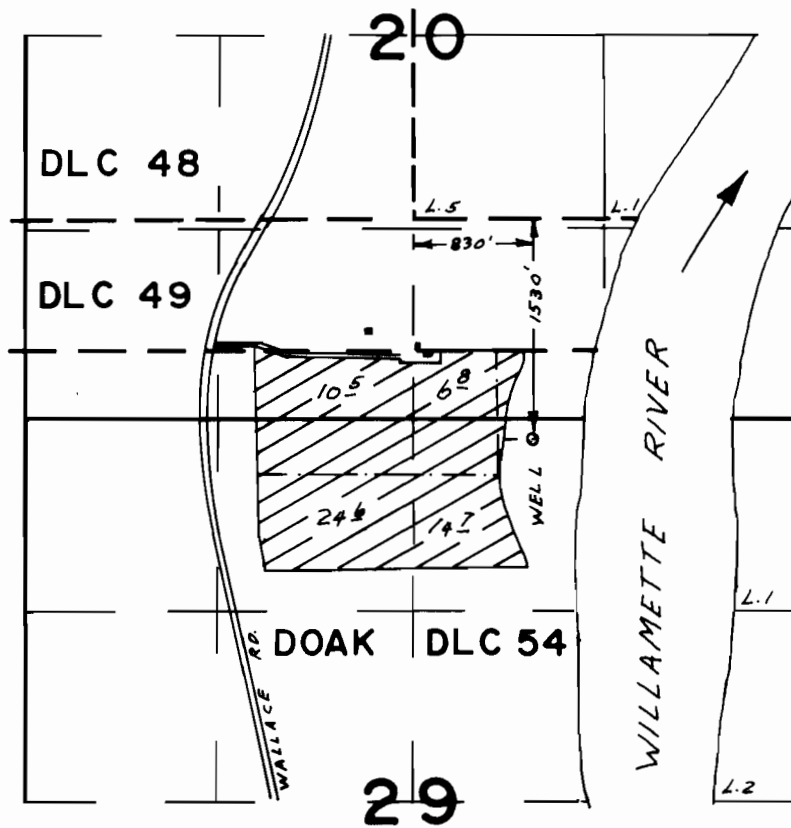

FINAL PROOF SURVEY
UNDER

Application No. G-5537. Permit No. G-5421.
IN NAME OF

HAROLD M. & HELEN M. CHERRY

Surveyed OCT. 13, 1975, by L.H. NUNN