


T.2N. R.2W. W.M.

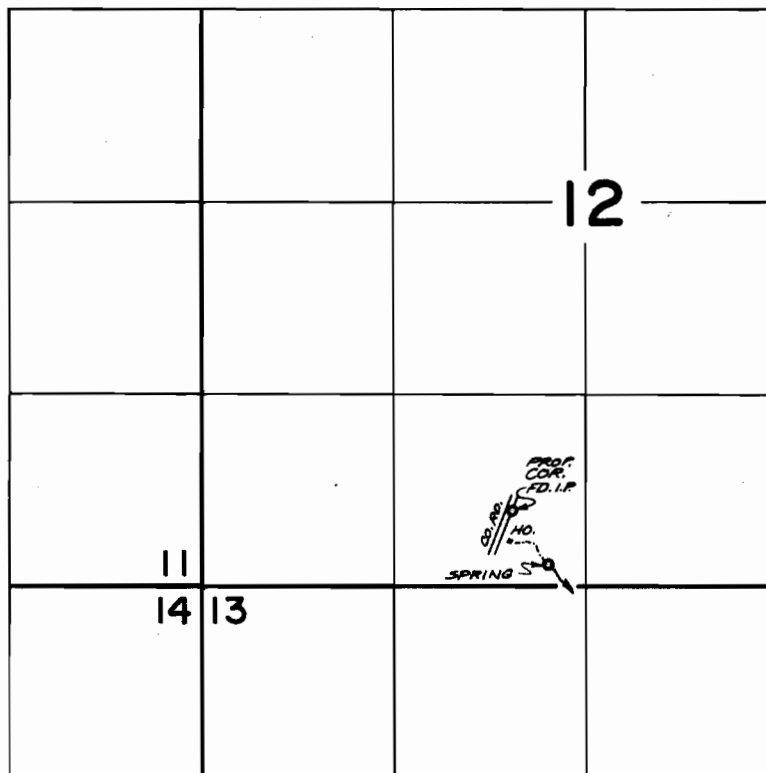

SPRING LOCATED 150' N. & 250' W. FROM S. 1/4 COR. SEC. 12

FINAL PROOF SURVEY
UNDER

Application No. 51624... Permit No. 37398...
IN NAME OF

.....TODD WINFIELD DUNCAN.....

Surveyed JULY 10, 1975, by RGMUCKEN.....