


T.39S., R.41E., W.M.

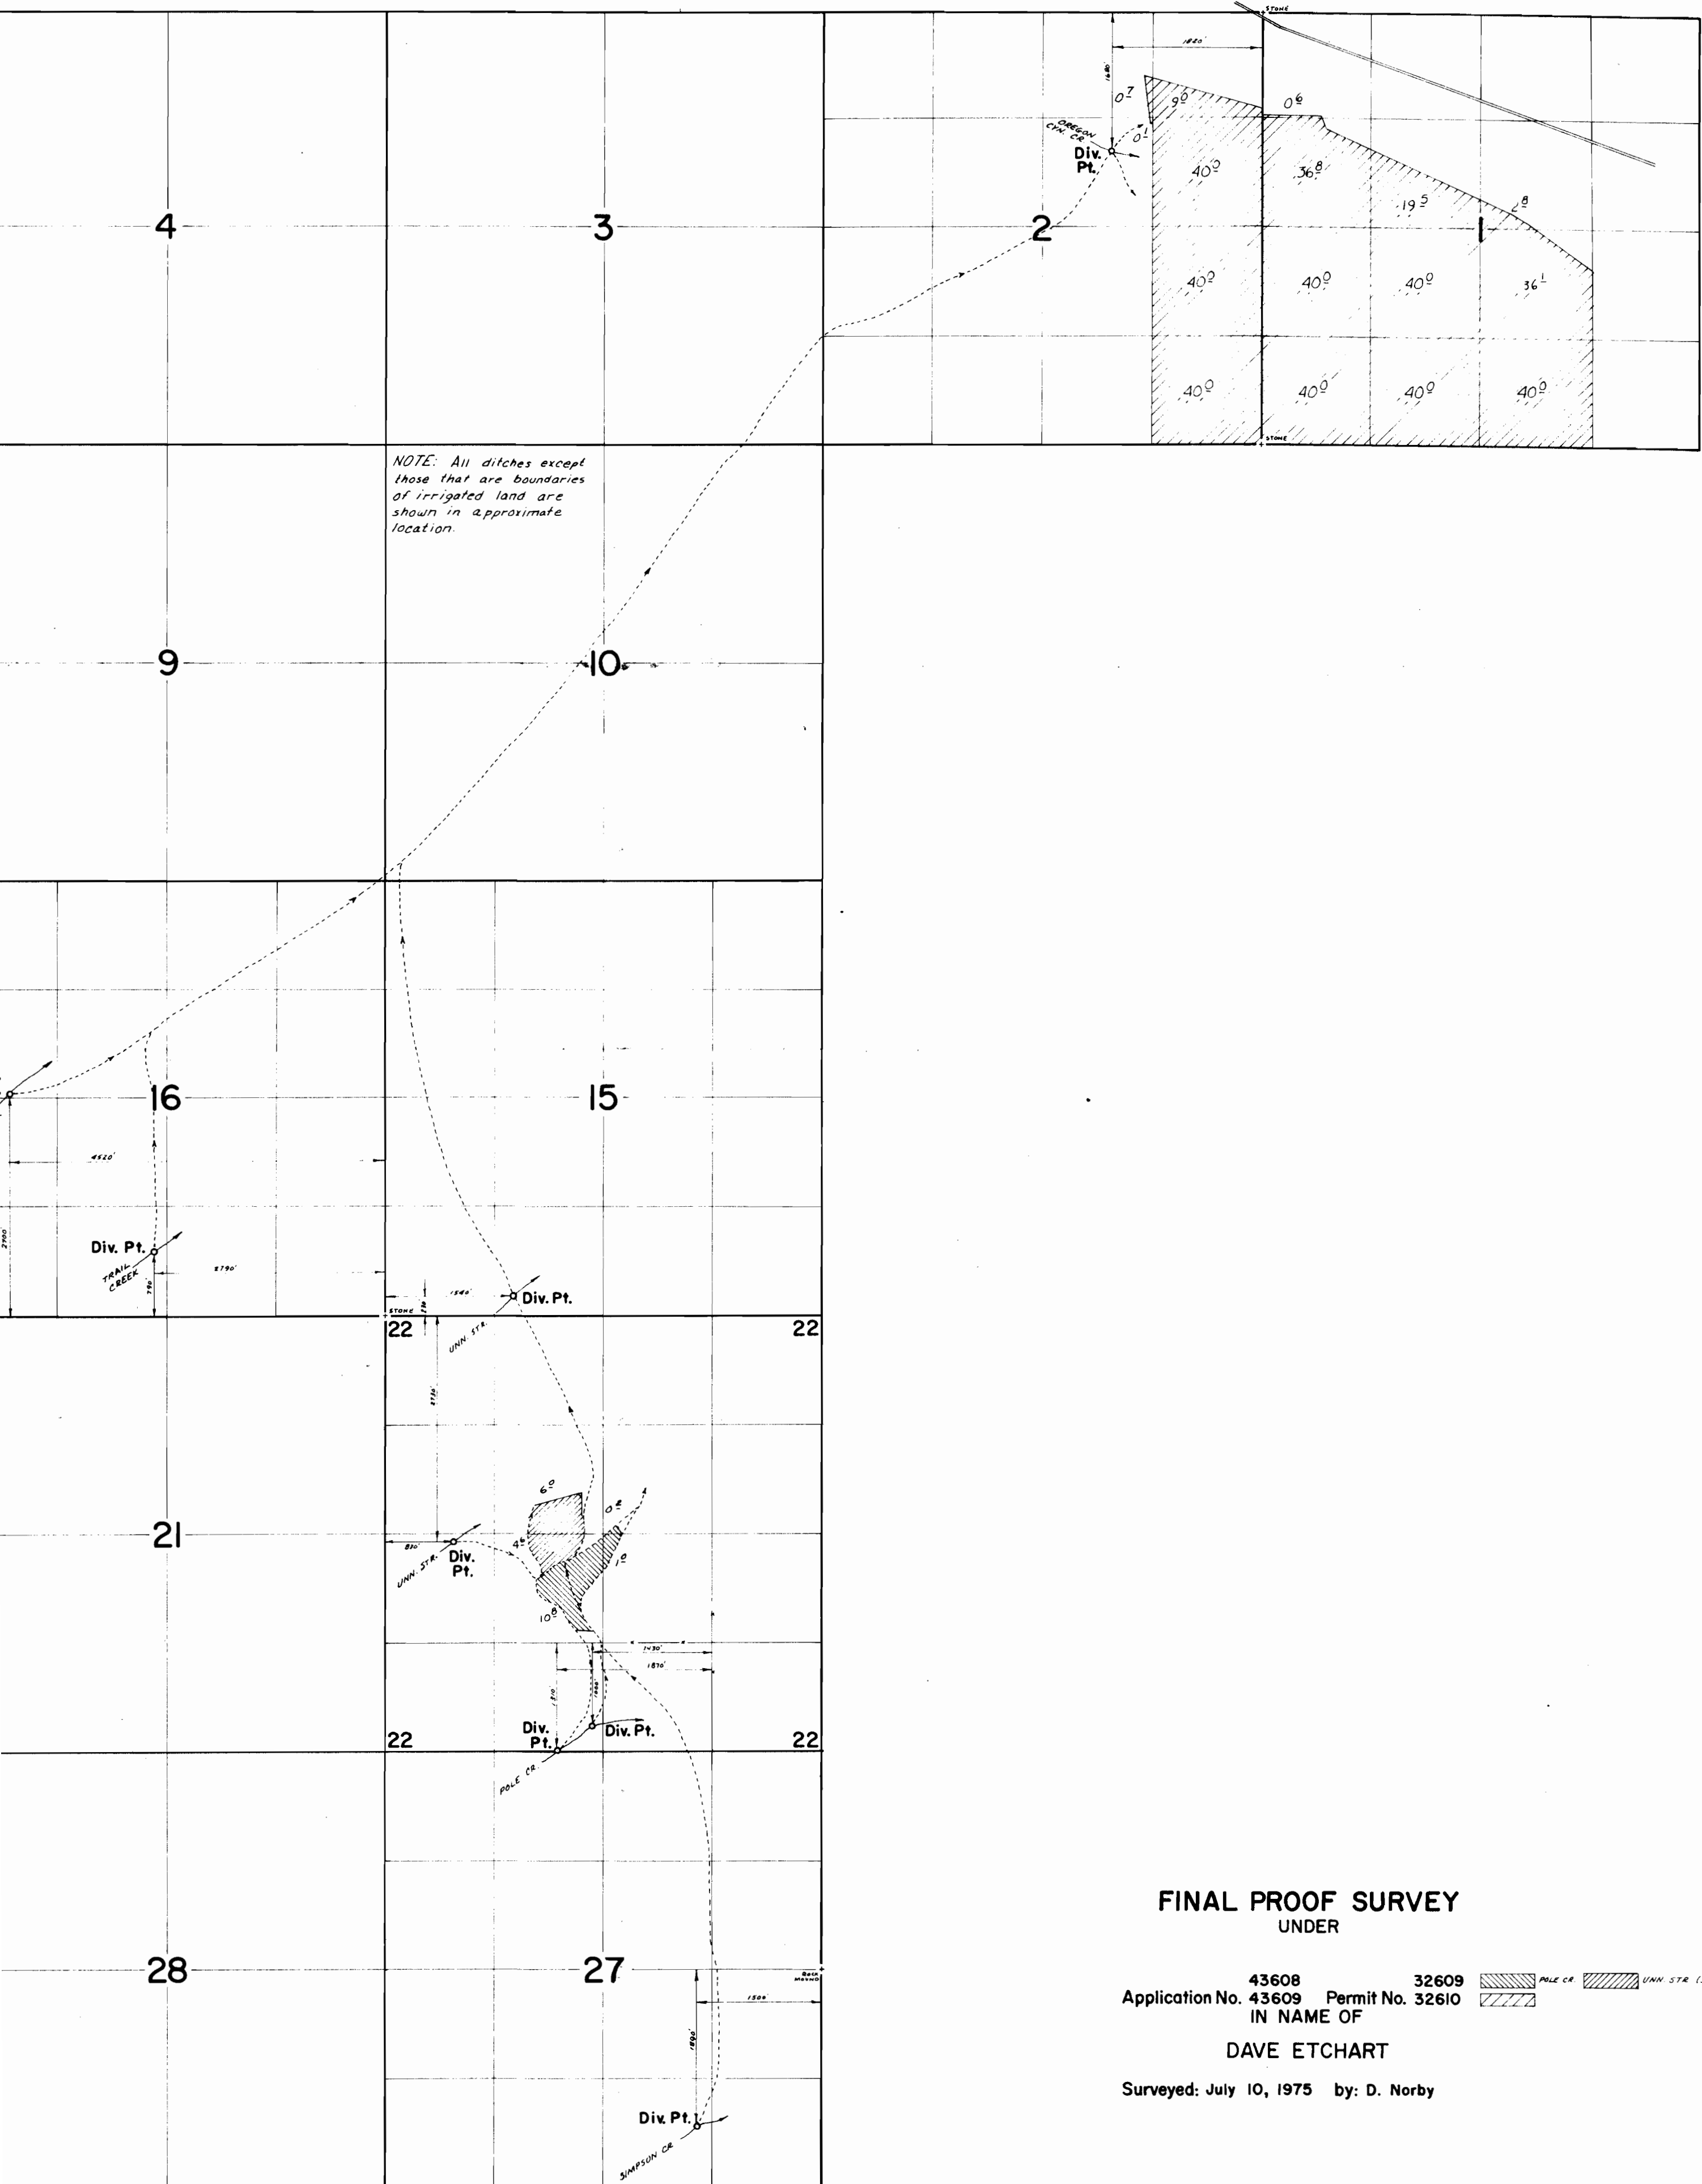

FINAL PROOF SURVEY
UNDER

Application No. 43608 Permit No. 32609
IN NAME OF

DAVE ETCHART

Surveyed: July 10, 1975 by: D. Norby

POLE CR. UNN. STR. (SOUTH)