


T.6S. R.6W. W.M.

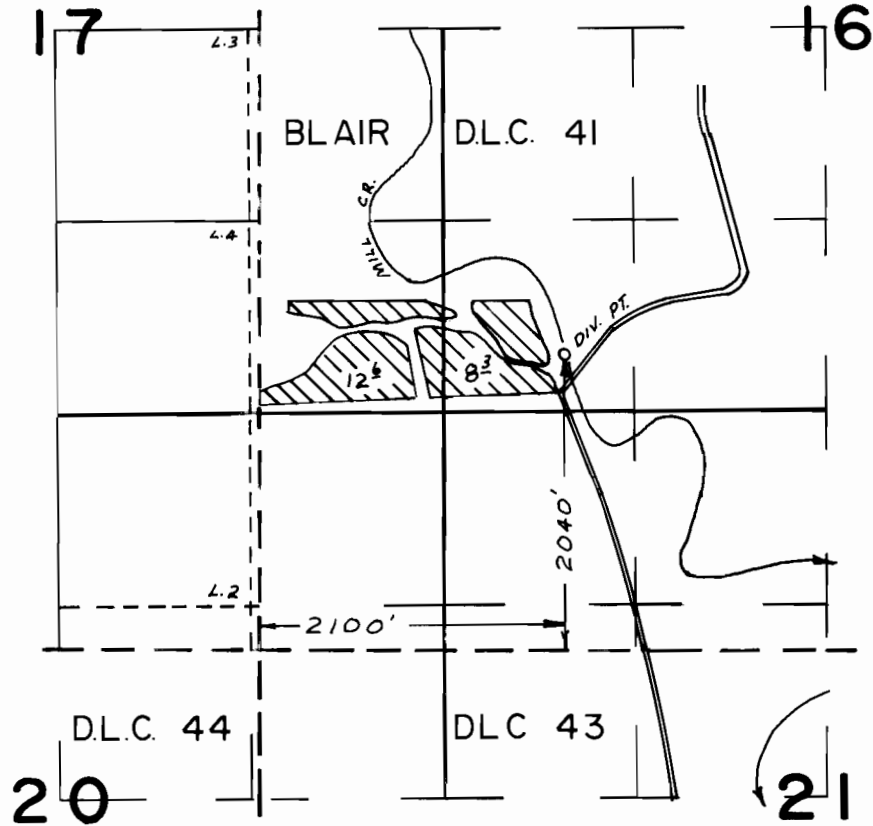

FINAL PROOF SURVEY
UNDER

Application No. 49766... Permit No. 36760...
IN NAME OF

.....WILLIAM H. PAASCH.....

Surveyed OCT. 14. 1975., by L.H. NUNN.....