


T.6S. R.7W. W.M.

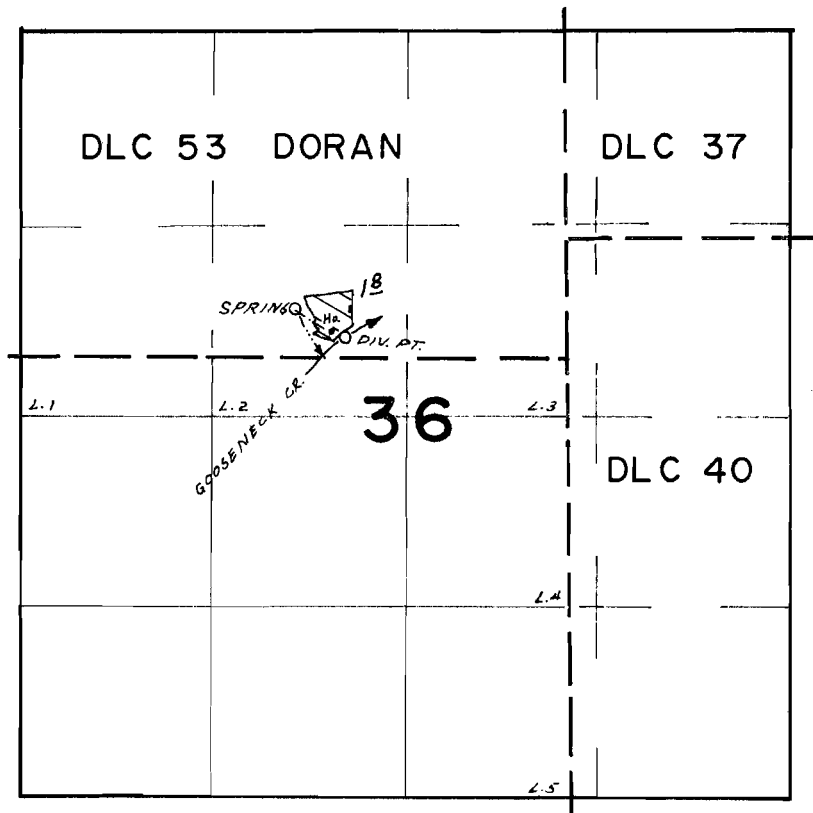

SPRING LOC. 340' N. & 1830' W. } BOTH FROM SE COR. DLC 53
DIV. PT. LOC. 140' N. & 1530' W. }

FINAL PROOF SURVEY

UNITED STATES

Department No. 50159 Section No. 37681

IN NAME OF

EARLINE J. HERTZLER

Surveyed OCT. 15, 1975, by L.H. NUNN