


T. 9 S. R. 5 W. W.M.

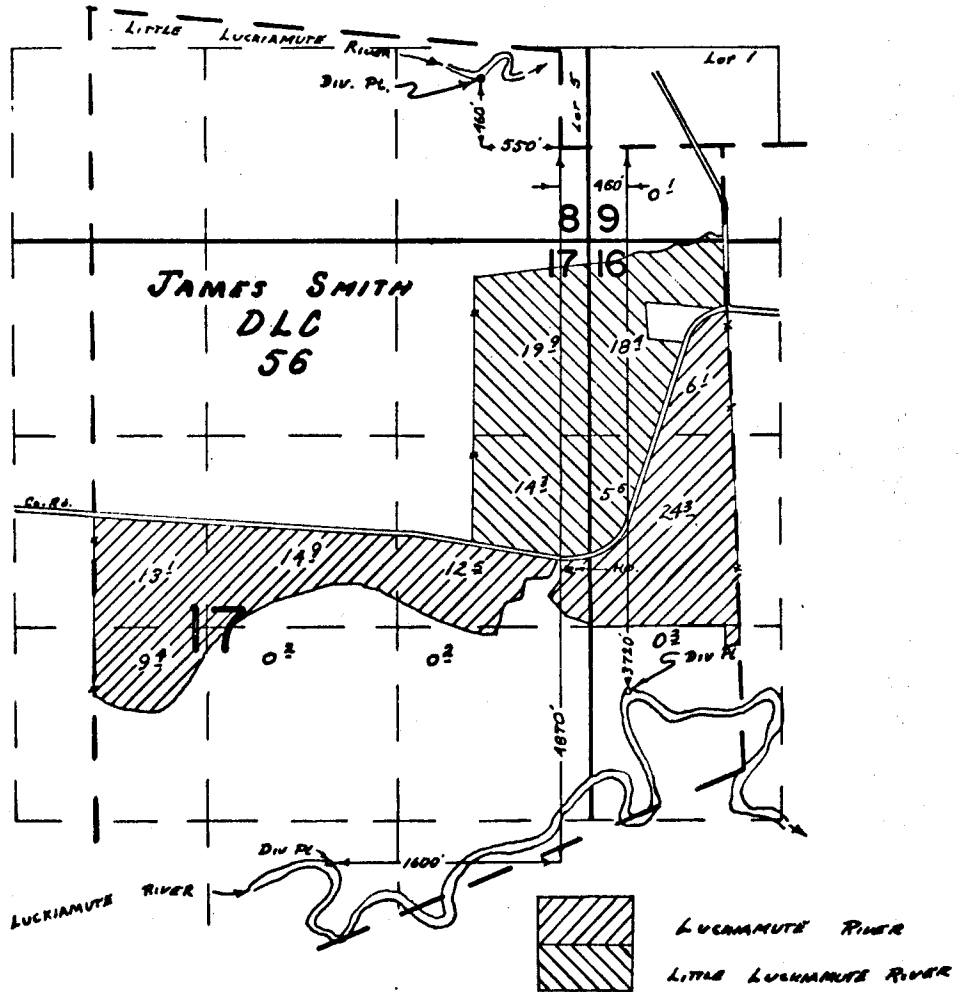

FINAL PROOF SURVEY
UNDER

Application No. 46036 Permit No. 34380
IN NAME OF

C. A. TWISS

Surveyed MAR. 15 1973, by R. B. MUCKEN