


T. 1 S. R. 8 W. W. M.

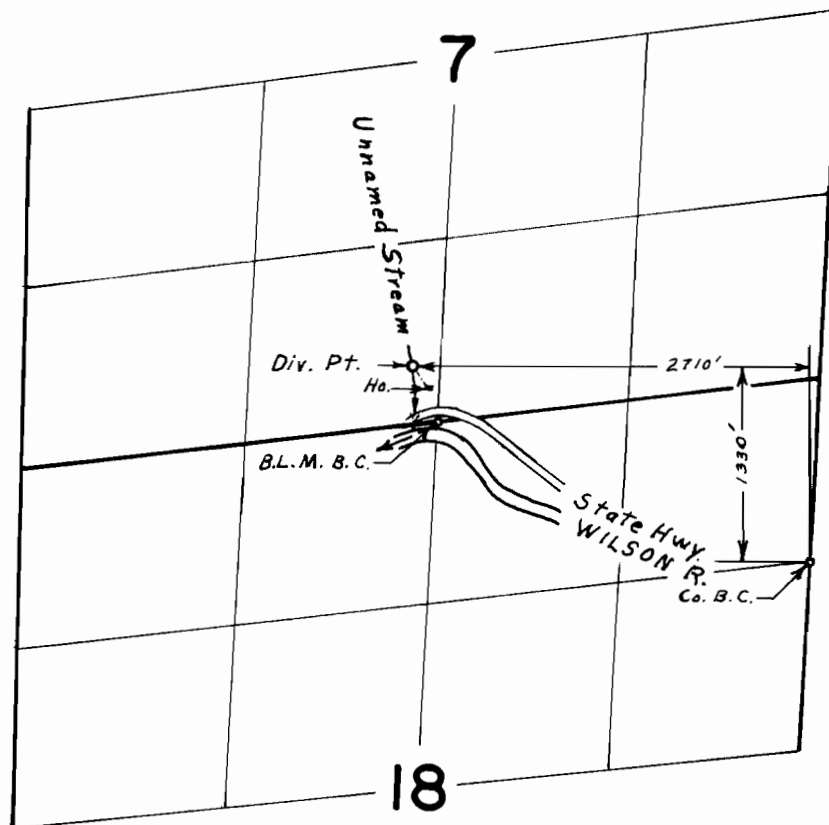

FINAL PROOF SURVEY
UNDER

Application No. 34759 Permit No. 27391
IN NAME OF

A. Burton Appling

Surveyed June 11, 1971, by L. E. Gould
SEPT. 12, 1974 R. MUCKEN