


44898 G-4326

T6N. R.36E. W.M.

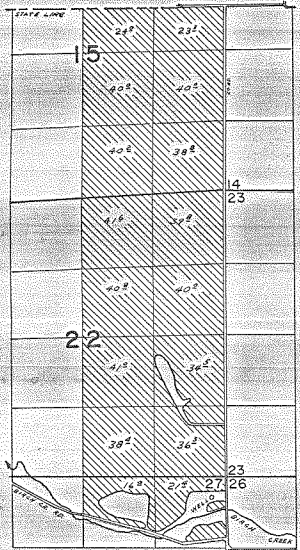

WELL LOC. 400' S. & 250' W. FROM NE COR. SEC. 27

FINAL PROOF SURVEY
 UNDER
 Application No. 9-4602, Permit No. 9-4326
 IN NAME OF
HELEN D. & H.T. REA
 Surveyed APR. 5, 1975, by L.H. NUNN