


G-4962

44900

# T.2N. R.30E. W.M.

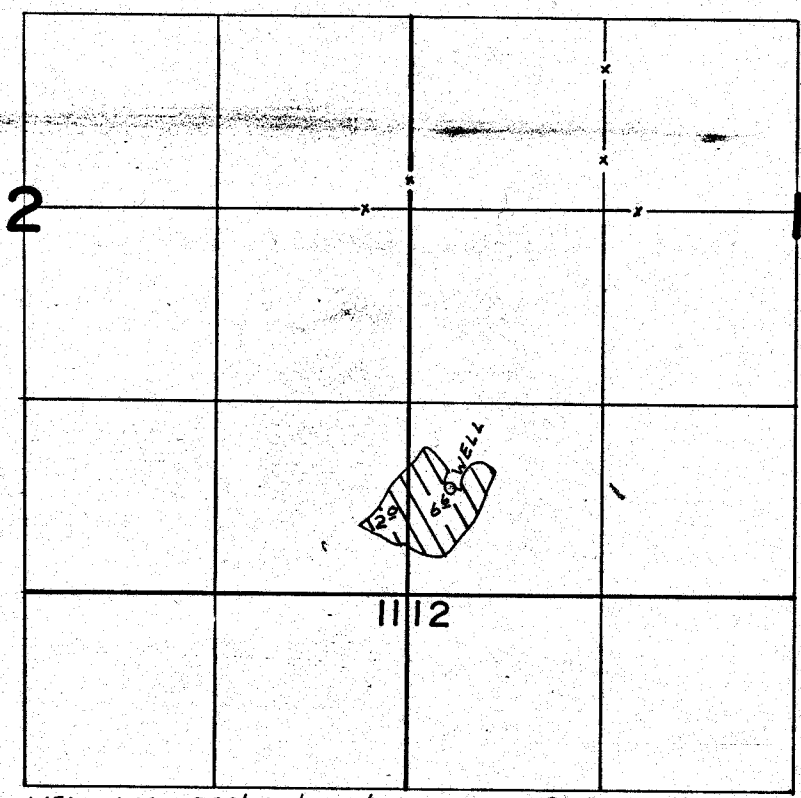

WELL LOC. 730' N. & 300' E. FROM SW COR. SEC. 1

## FINAL PROOF SURVEY UNDER

Application No. G-5732 Permit No. G-4962  
IN NAME OF

EDWARD W. HOLMES

Surveyed APR. 10, 1975, by L.H. NUNN