


# T.4N.R.34E.W.M.

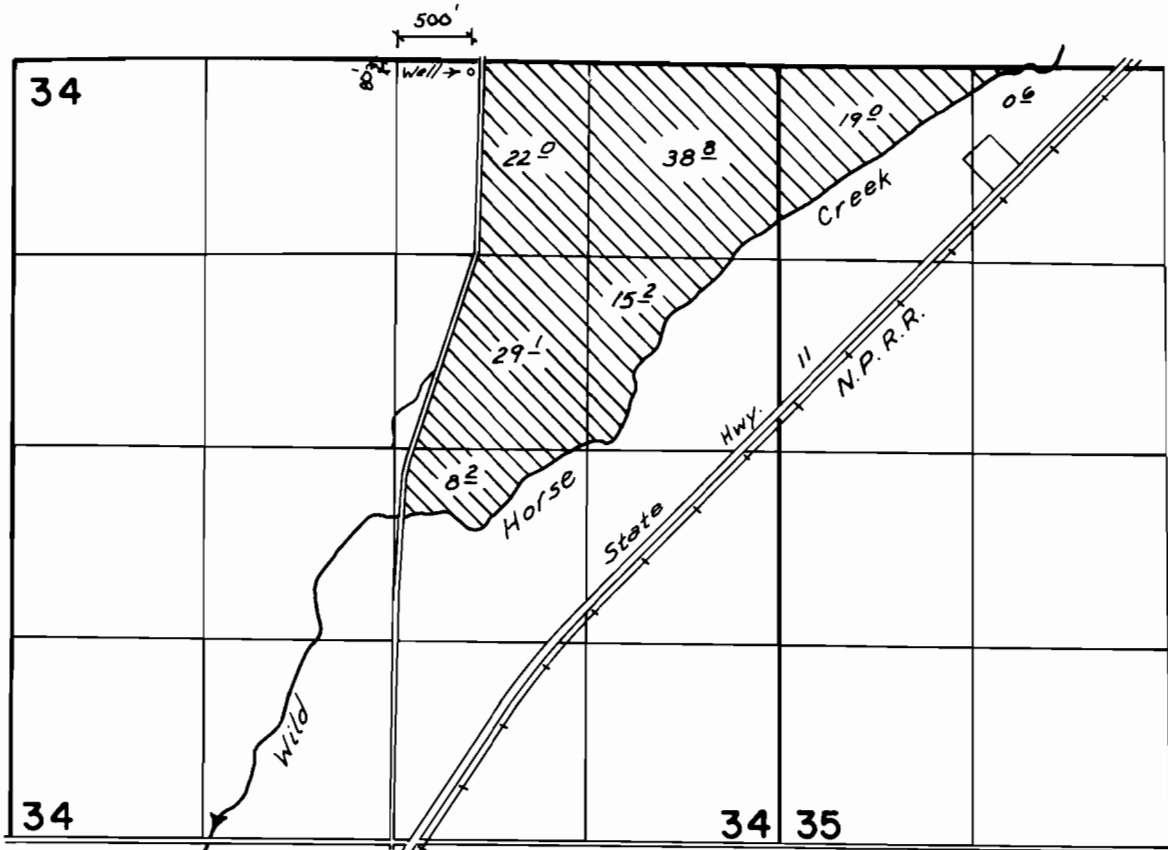

## FINAL PROOF SURVEY UNDER

Application No. G-5370 Permit No. G-5305  
IN NAME OF  
B. L. DAVIS RANCH, INC.

Surveyed April 9, 1976, by L. M. Toll