


# T.6S. R.31E. W.M.

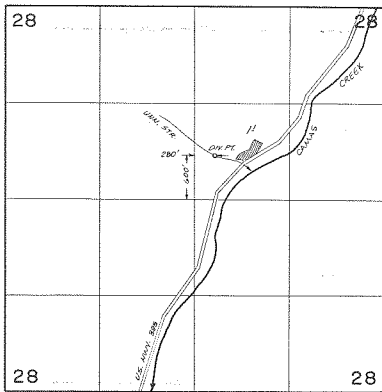

## FINAL PROOF SURVEY UNDER

Application No. 44658 Permit No. 33437  
IN NAME OF  
John R. & Mary Jane Hershey  
Surveyed APRIL 7, 1975, by D. NORBY