


T. 1N. & 1S. R. 48E. W.M.

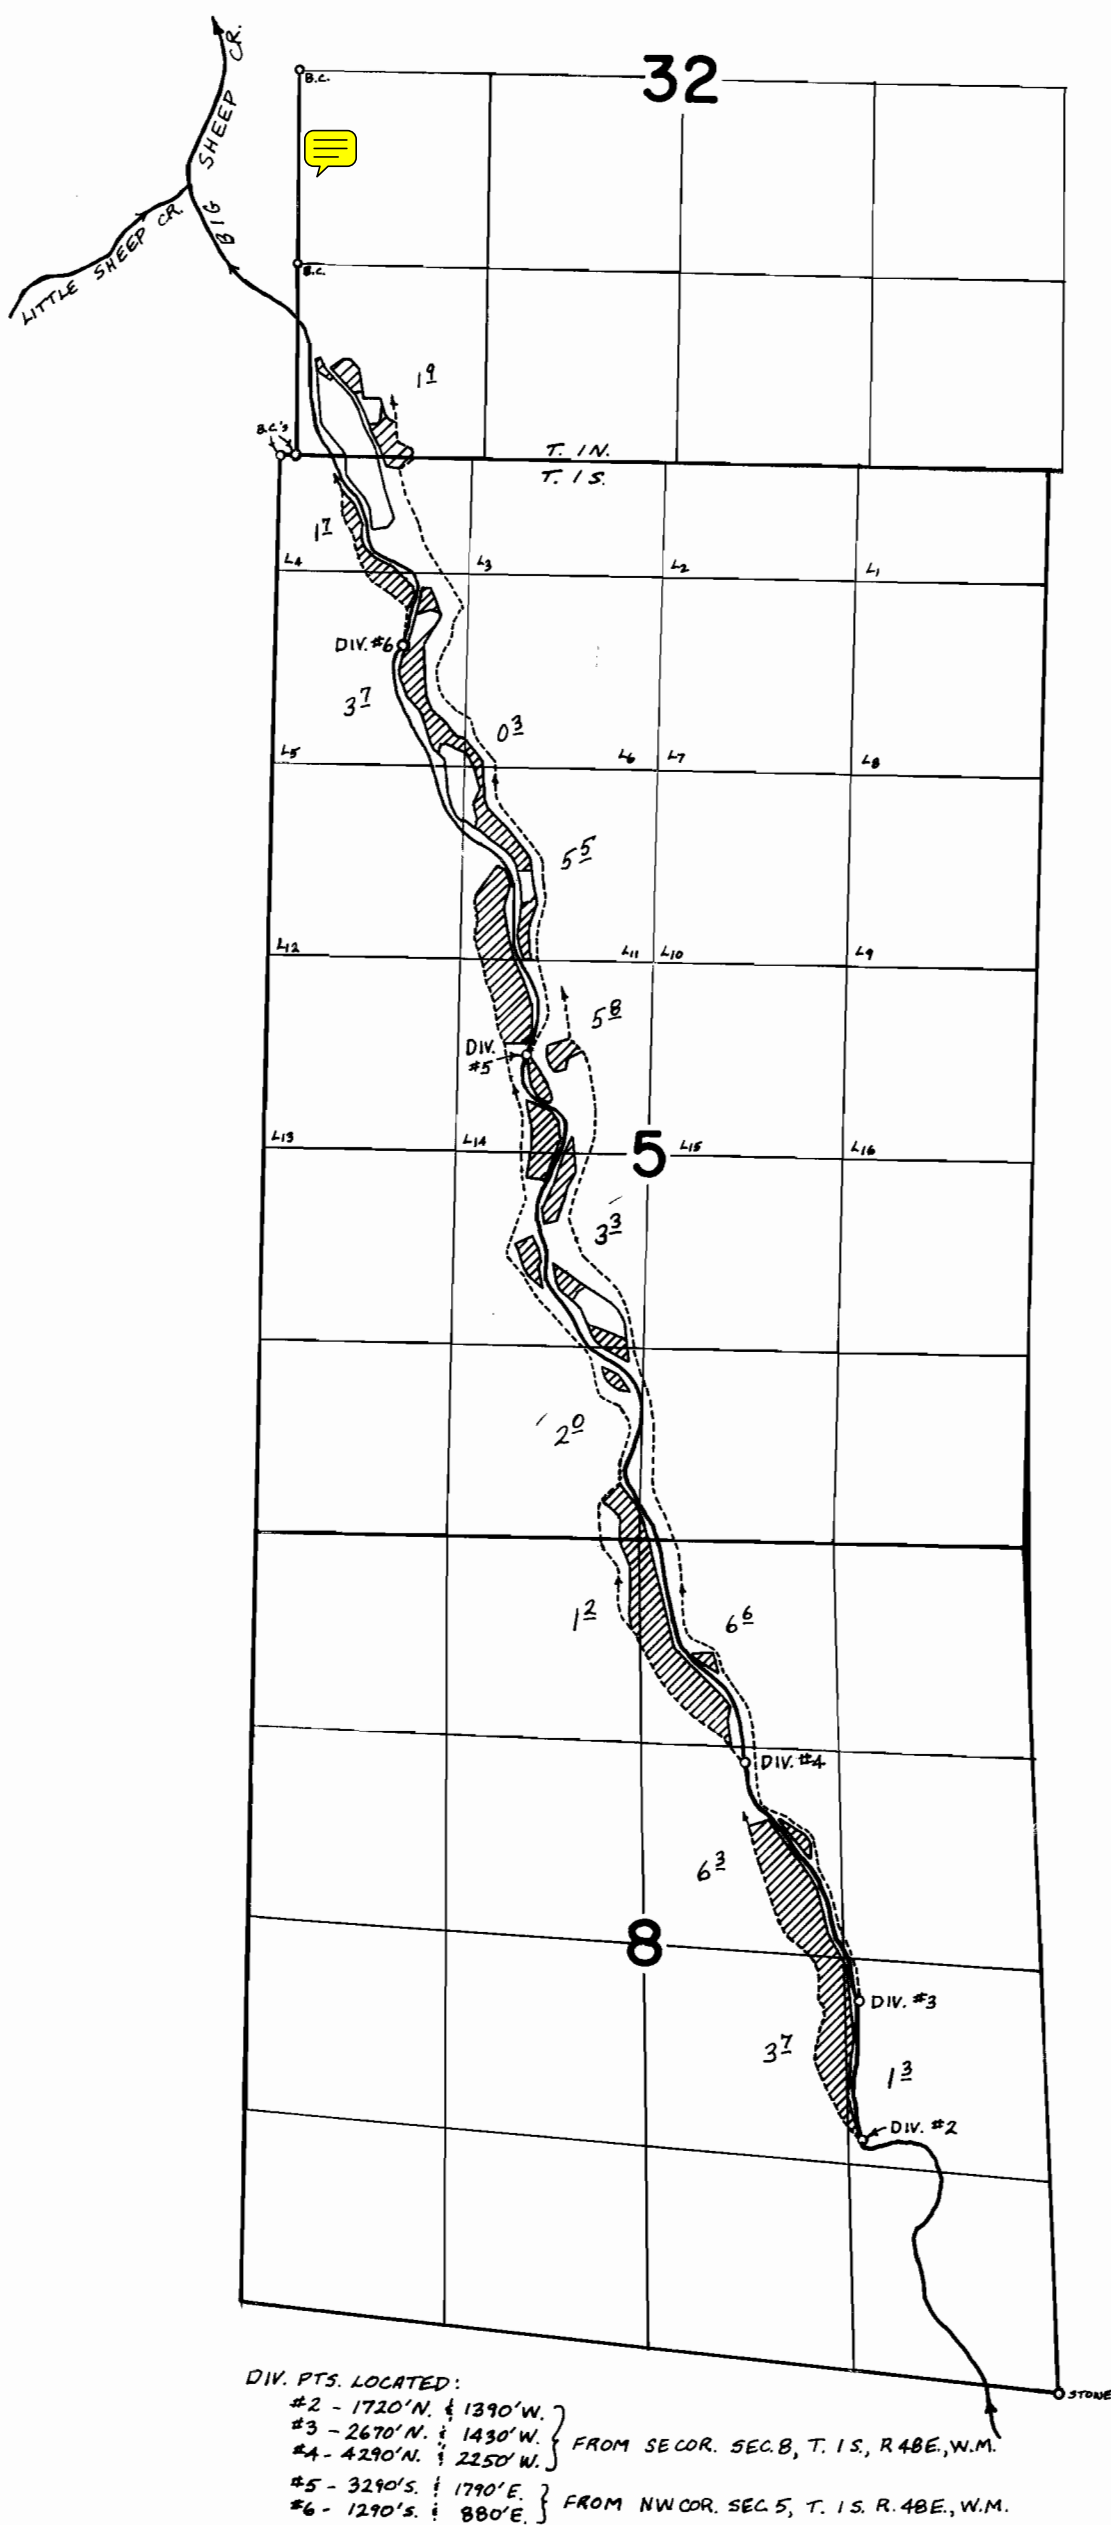

FINAL PROOF SURVEY

UNDER

APPLICATION NO. 45727 PERMIT NO. 34138
IN NAME OF

R. A. BORGERDING

SURVEYED AUGUST 9, 1973 BY R. G. MUCKEN
AUGUST 13, 1973 D. M. NORBY
OCTOBER 30, 1975 L. H. NUNN