


T. 1N. R. 48E. W.M.

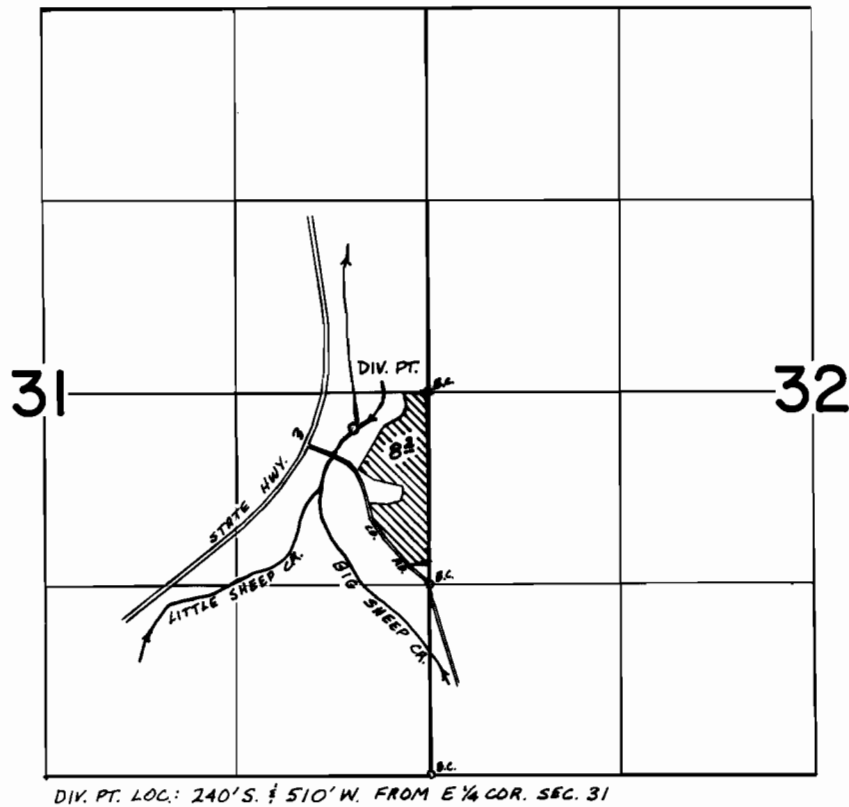

FINAL PROOF SURVEY UNDER

Application No. 46968 Permit No. 35142
IN NAME OF

CHAS. H. LYDALL

Surveyed OCT. 30 1975, by L. H. NUNN