


T. 3S. R. 45E. W.M.

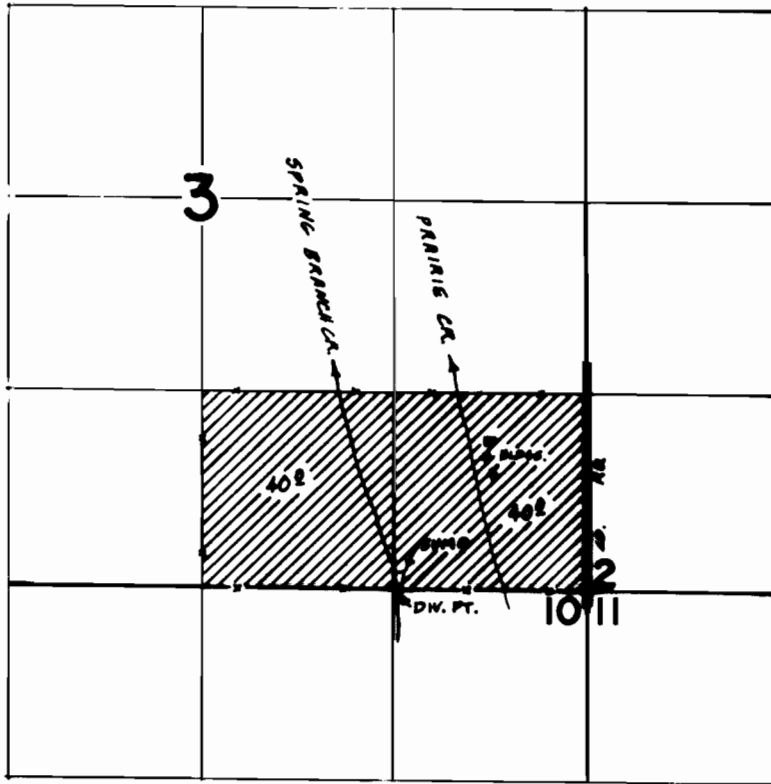

SUMP LOC: 70' N. & 1290' W. & DIV. FROM SPRING BRANCH CR. LOC:  
10' N. & 1310' W., BOTH FROM SE COR. SEC. 3

**FINAL PROOF SURVEY**  
UNDER

Application No. 6-6279 51138 Permit No. 6-5234 37390  
IN NAME OF

JOHN A. PRAG

Surveyed NOV. 3 1975, by L. H. NUNN