


T.1N. R.12E. W.M.

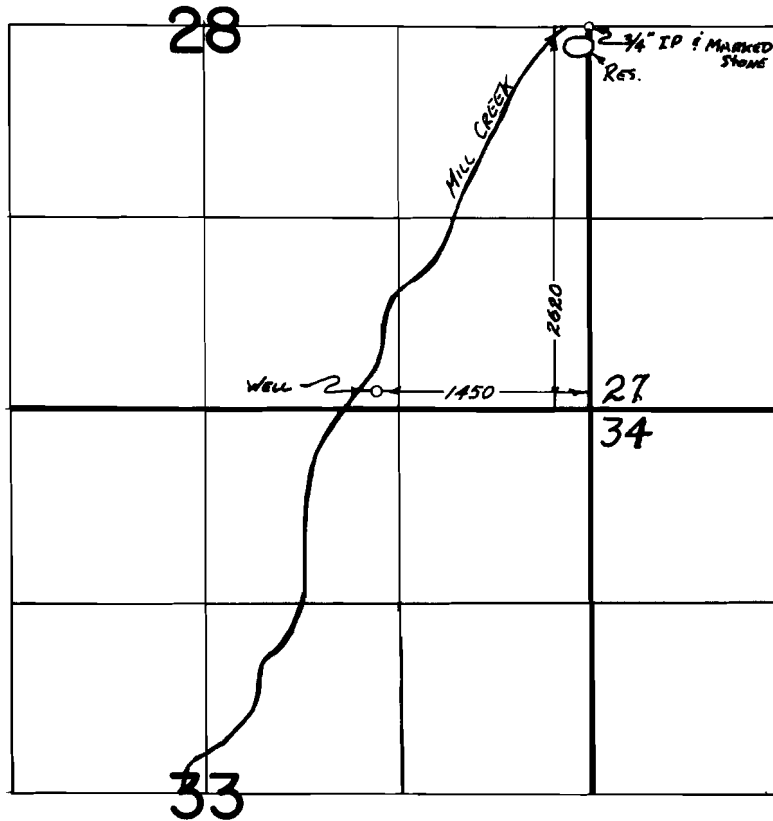

FINAL PROOF SURVEY
UNDER

Application No. G-2076 Permit No. G-2132
IN NAME OF

CITY OF THE DALLES

Surveyed APRIL 5, 1976 by R.G. MUCKEN