


T.2N. R.12E. W.M.

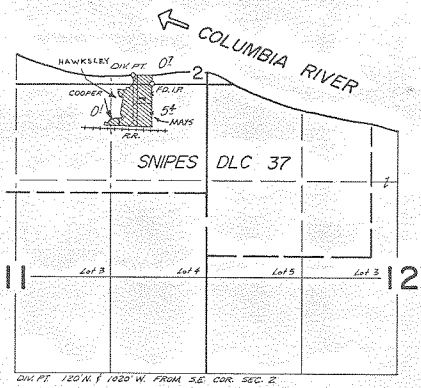

FINAL PROOF SURVEY UNDER

Application No. 50009 Permit No. 37107
IN NAME OF

EARL B. & LOIS M. COOPER, CARL F. & VELMA P. MAYS
WILLIAM J. & DOROTHY D. & KIM HAWKSLEY
Surveyed JUNE 3, 1975, by R.G. MUCKEN