


T.2S. R.1W. W.M.

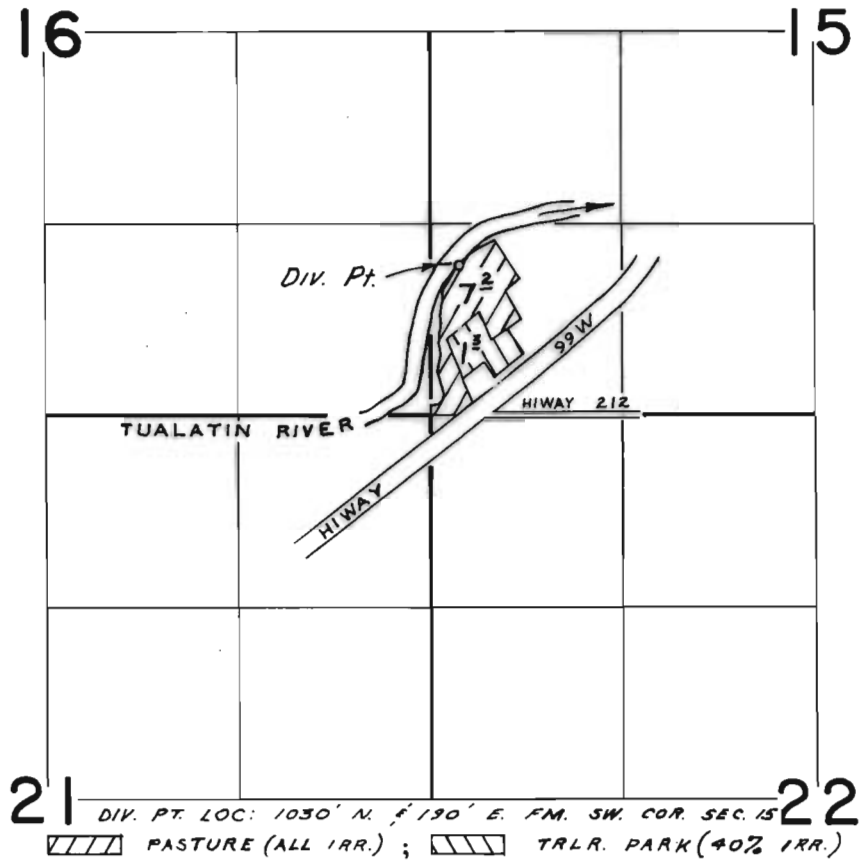

**FINAL PROOF SURVEY**  
UNDER

Application No. 47378 Permit No. 35483  
IN NAME OF

.....**RESSELL ESPEDAL**.....

Surveyed May 15 1975, by R. Mucken.