


T.1S., R.3W., W.M.

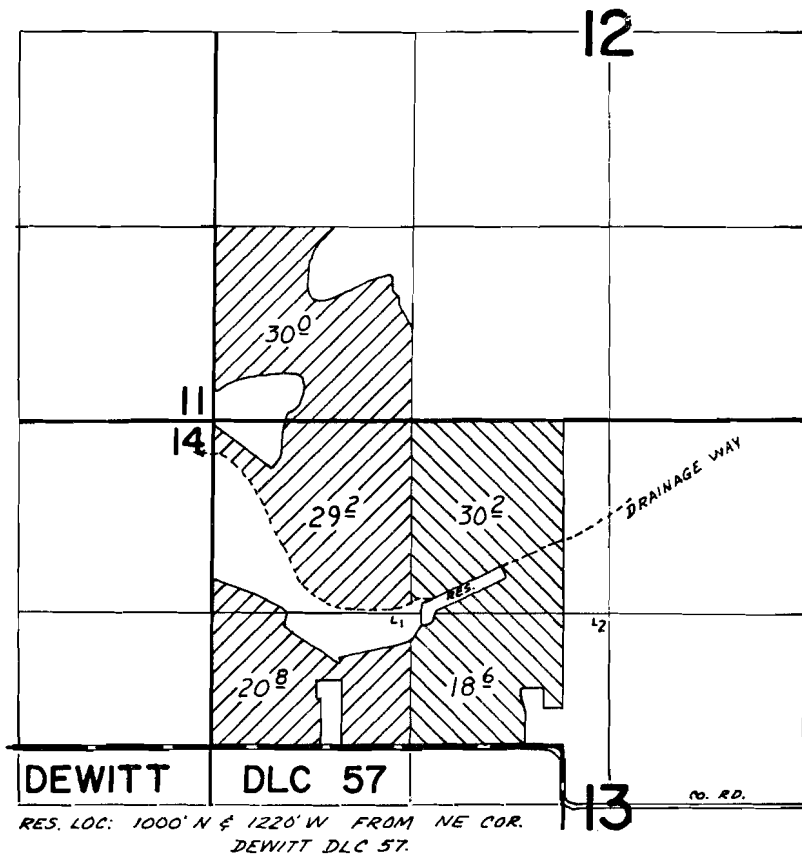

 PRIMARY
 SUPPLEMENTAL

FINAL PROOF SURVEY UNDER

R-49954 R-6096
 Application No. 49955 Permit No. 37581
 IN NAME OF

DONALD C. JESSE

Surveyed Aug. 5 1975, by R.G. Mucken