


# T.1S., R.3W., W.M.

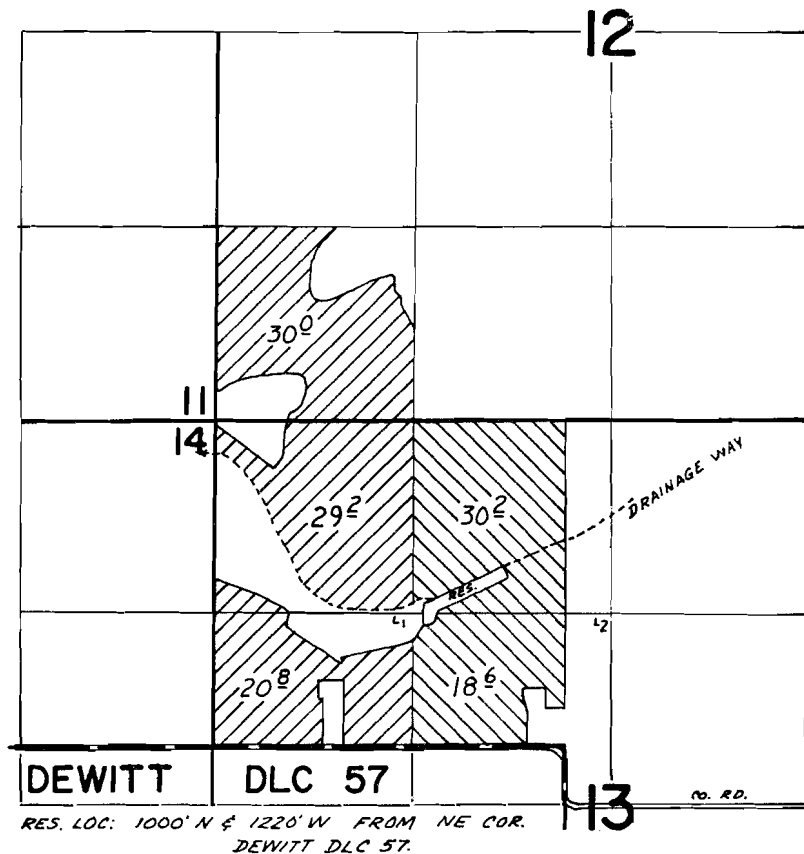

 PRIMARY  
 SUPPLEMENTAL

## FINAL PROOF SURVEY UNDER

Application No. R-49954 49955 Permit No. R-6096 37581  
 IN NAME OF

DONALD C. JESSE

Surveyed Aug. 5 1975, by R.G. Mucken