


T. 4 S. R. 3 W. W.M.

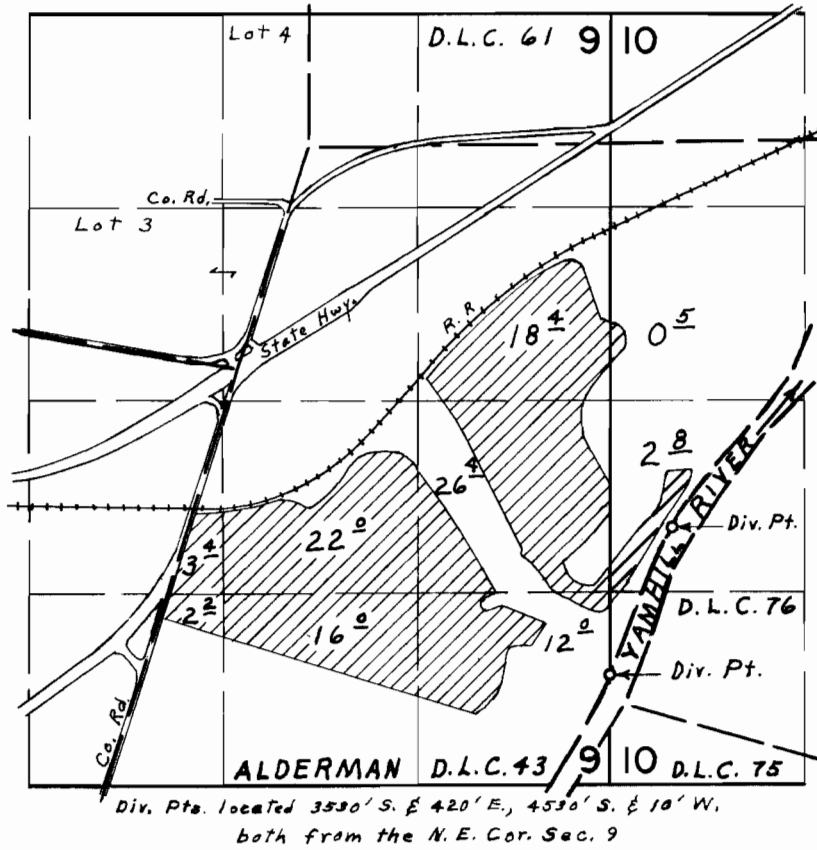

FINAL PROOF SURVEY UNDER

Application No. 49172 Permit No. 36861
IN NAME OF

PHILLIP A. HAWMAN

Surveyed April 14, 1975, by L. E. Gould