


T. 5 S. R. 1 E. W. M.

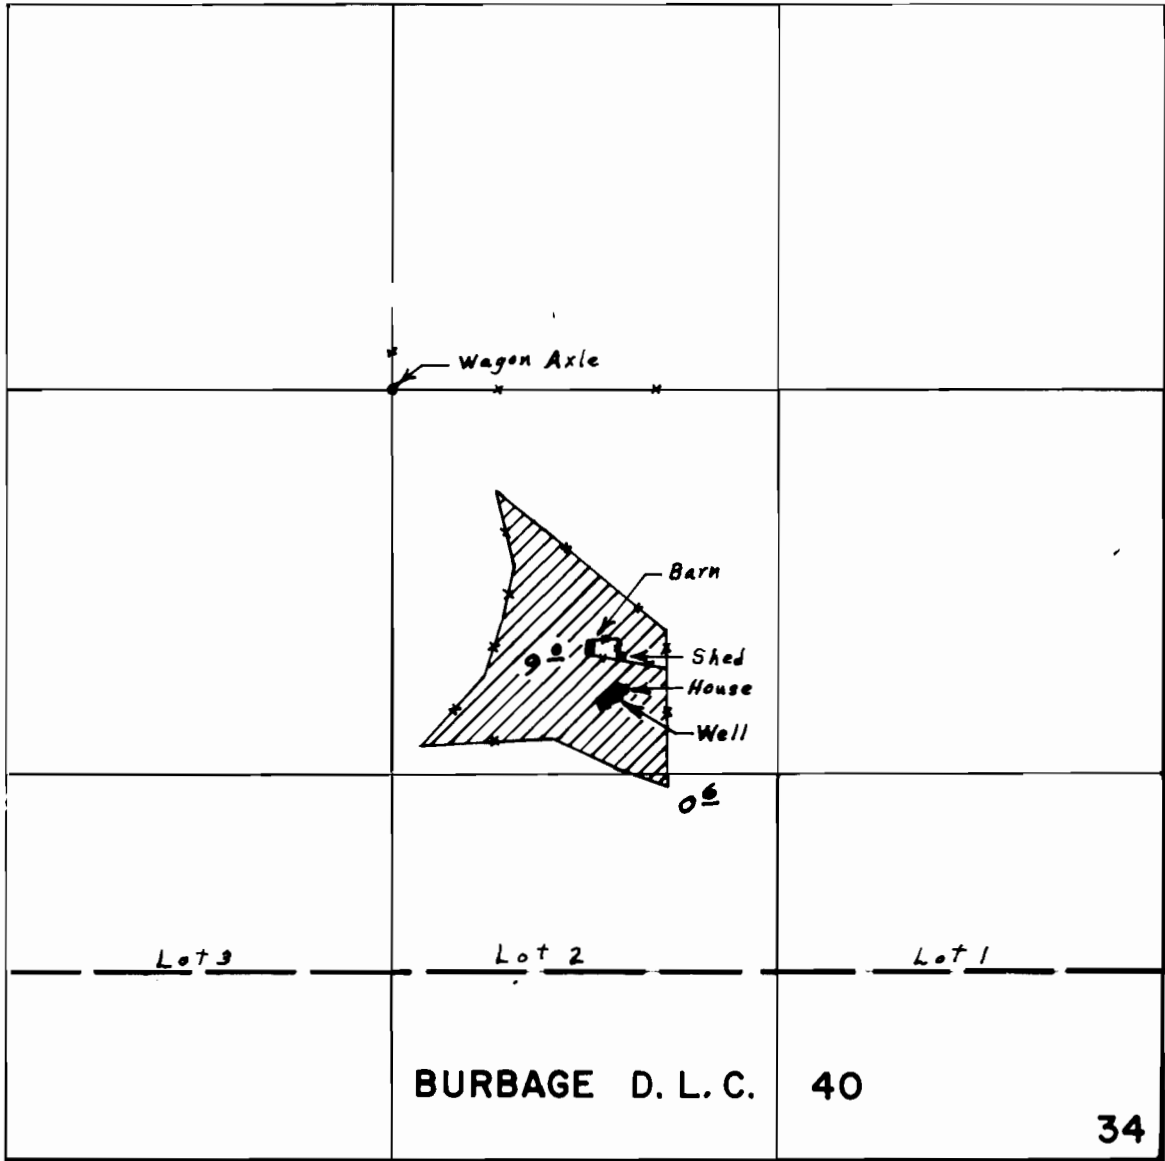

Well located 1060' S. & 770' E. from Center Section 34

Scale 1" = 660'

FINAL PROOF SURVEY
UNDER

Application No. G-6231 Permit No. G-5245
IN NAME OF

JOSEPH DOBBES

Surveyed Sept. 9, 1976, by L. E. Gould