


T. 3S. R. 1E. W.M.

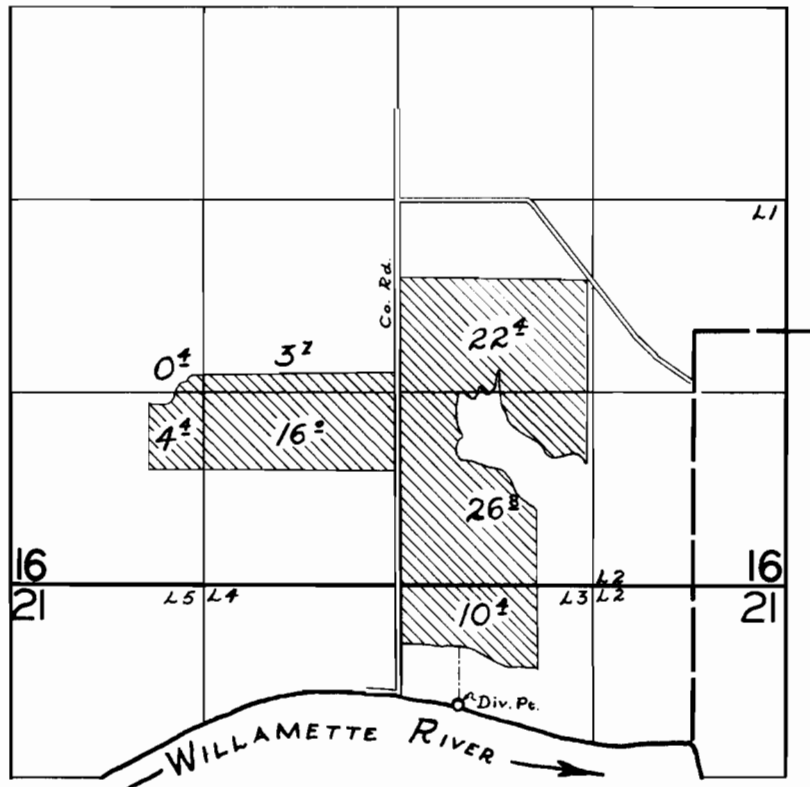

FINAL PROOF SURVEY

UNDER

Application No. 27378 Permit No. 21553

IN NAME OF

GEORGE E. & MARY H. FELL

Surveyed SEPT. 3 19 59, by R. H. JACKSON